
T. 37 S., R. 5 W., W.M.

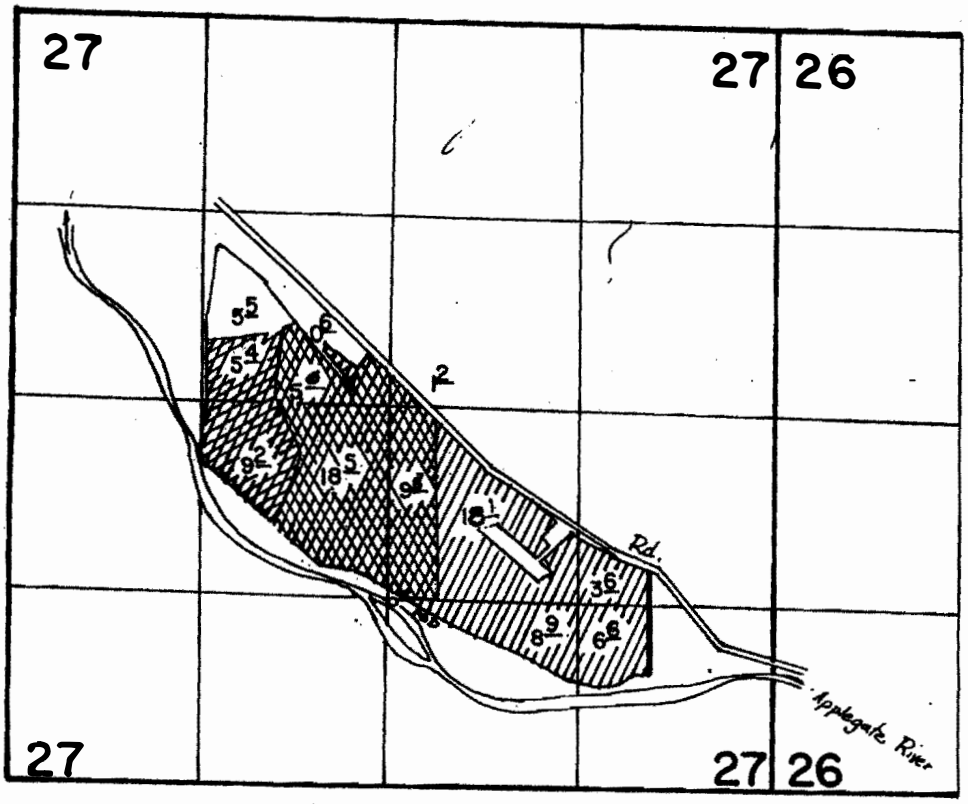

Div. Pt. located 50' S. & 50' E. from N.W. corner of S.W. 1/4 SE. 1/4 Section 27.

FINAL PROOF SURVEY

UNDER

TRANSFER NO. 3734

Application No. 54190 62385.. Permit No. 40714 46526..... primary supplemental supplemental supplemental

IN NAME OF

ROBERT MILTON & RECO HILL

Surveyed JULY 27, 1982., by B.R. SUND

179-110L mc 2/84