


T.37 S., R.5 W., W.M.

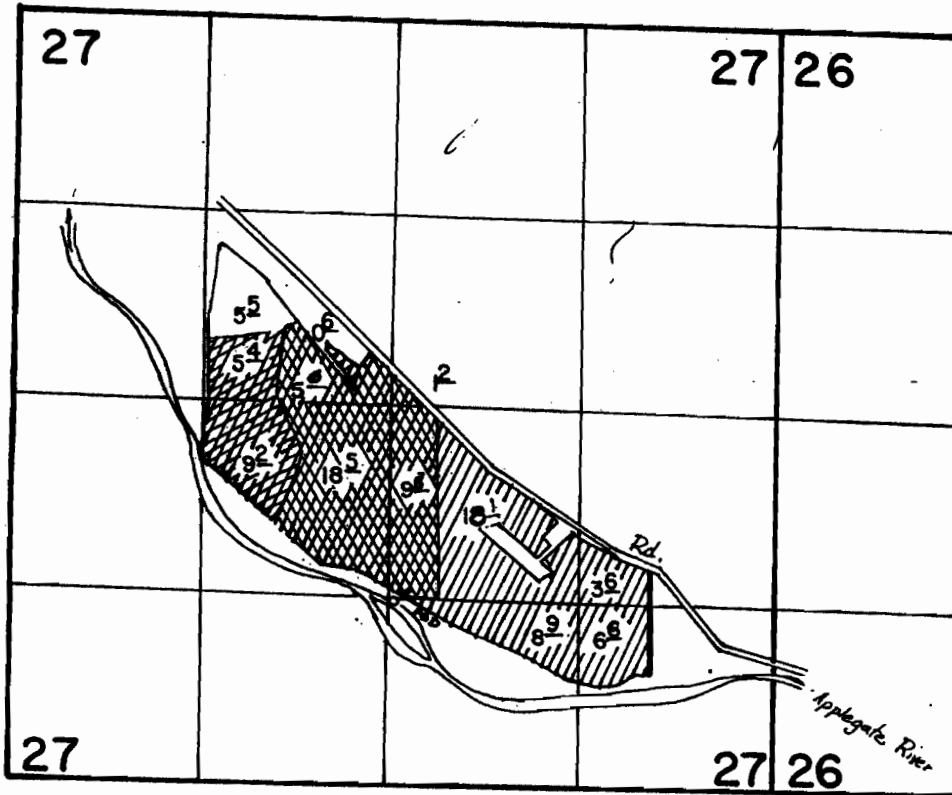

Div. Pt. located 50' S. & 50' E. from N.W. corner of
S.W. 1/4 SE. 1/4 Section 27.

FINAL PROOF SURVEY UNDER

TRANSFER NO. 3734

Application No. 54190 Permit No. 40714
 82385.. 46526.....

primary supplemental
 supplemental

IN NAME OF

ROBERT MILTON & RECO HILL

Surveyed JULY...27, 1982., by B. R. SUND.....