

SE1/4, SW1/4

SW1/4, SE1/4

75 FEET SOUTH
2200 FEET EAST
OF NW CORNER
SECTION 17
POINT OF DIVERSION


RECEIVED

OCT 31 2002

WATER RESOURCES DEPT.
SALEM, OREGON

FND
BCIP

7 8
18 17

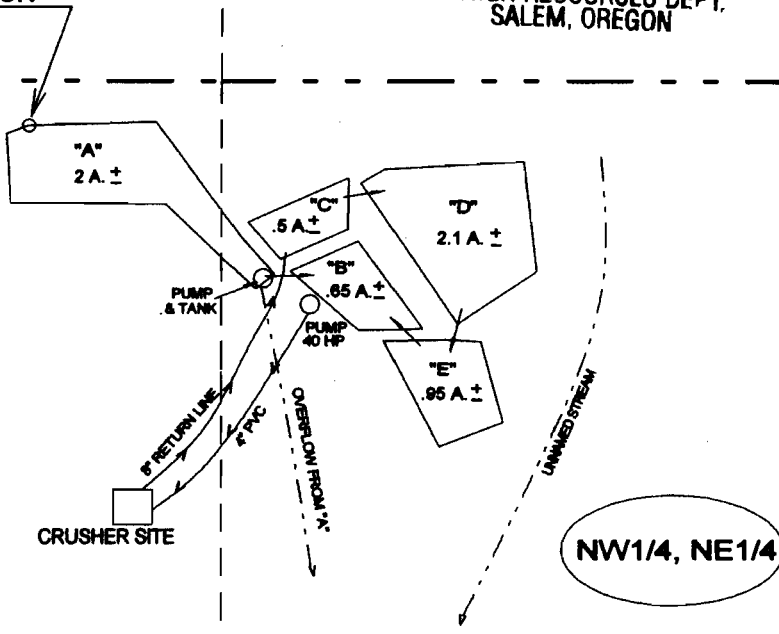

THE PREPARATION OF THIS MAP WAS FOR THE PURPOSE OF IDENTIFYING
THE LOCATION OF THE PROPOSED WATER RIGHT AND HAS NO INTENT TO
PROVIDE DIMENSIONS OR LOCATION OF PROPERTY LINES.

SECTION 17
T. 32 S., R. 15 W., W. M.
FINAL PROOF SURVEY

UNDER
APPLICATION #71492 PERMIT #52231

IN THE NAME OF
GEORGIA WAHL



1" = 400'

BRYAN FLAVIN LAND SURVEYING
BRYAN M. FLAVIN
REGISTERED LAND SURVEYOR
CERTIFIED WATER RIGHTS EXAMINER
32883 SQUAW VALLEY ROAD
GOLD BEACH, OREGON 97444
541-247-6485
CWRE #366

SURVEYED SEPTEMBER 18, 2000 BY BRYAN M. FLAVIN



GEORGIA WAHL
P. O. BOX 43
LANGLOIS, OR
97450

Map 1 of 2