


**CERTIFICATE NO. 81657 AND 81658**  
81672

# PLAT SHOWING AREA SERVED DOMESTIC WATER ROATS WELLS #1 and #2 Scale 4" = 1 MILE.

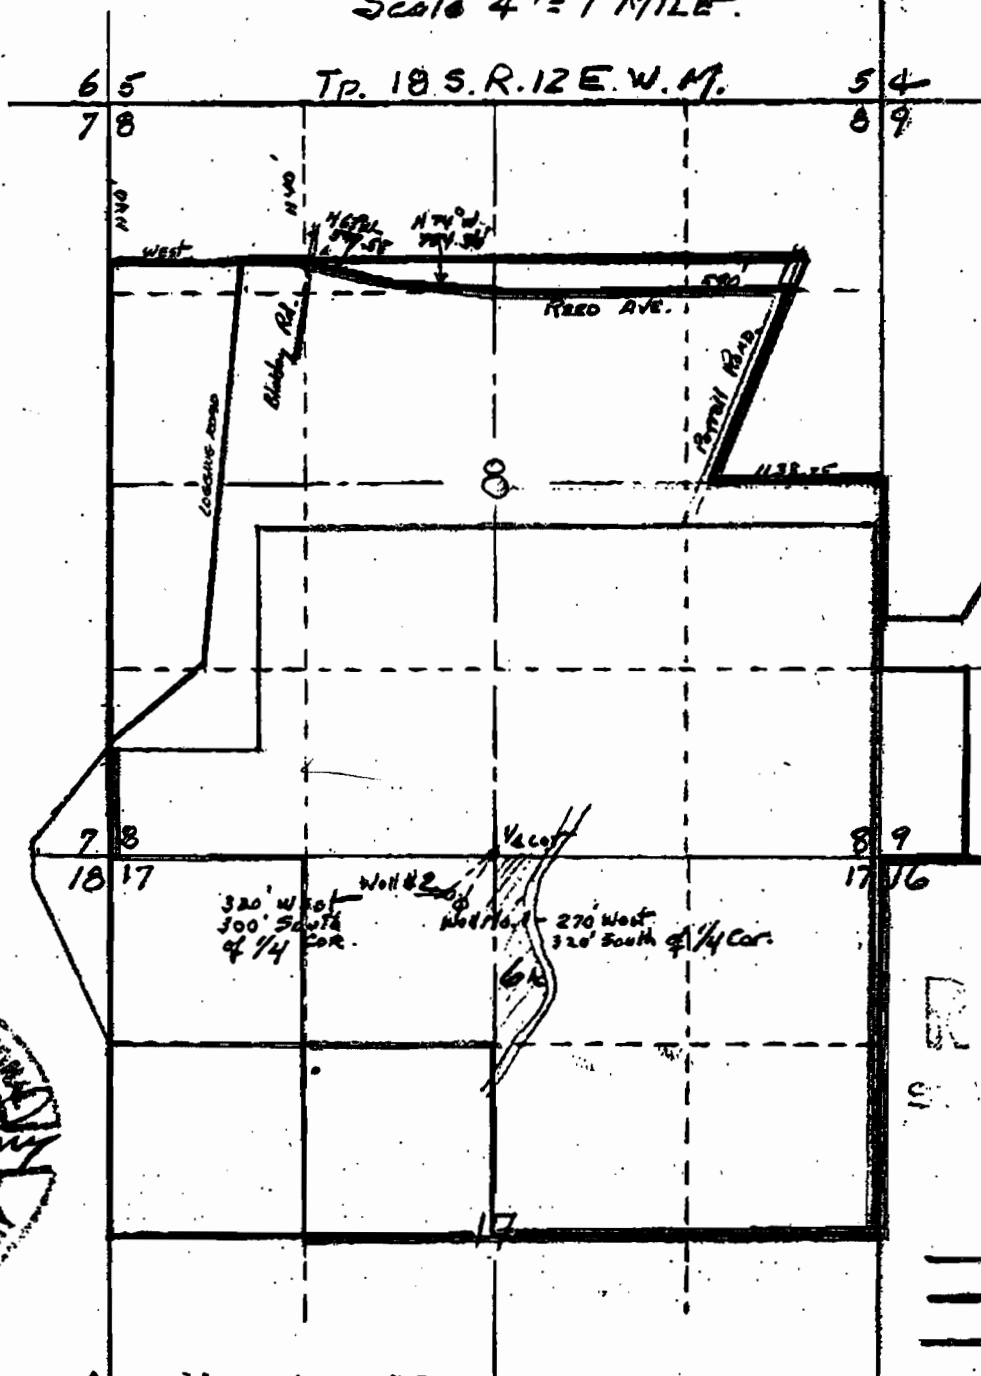

RECEIVED  
PL 23885  
STATE ENGINEER  
MILSON

— App G 1961  
- - - App G 3328  
— CLAIMED  
5-12-76

Application No. G-3328  
Permit No. G-3128



THIS MAP WAS PREPARED FOR  
ASSESSMENT PURPOSES ONLY.  
REVISED: 11/12/2002

**PARCEL NO.**

81672  
81658


NE 1/4 NW 1/4 SEC. 17 T. 18S. R. 12E. W.M.  
DESCHUTES COUNTY

1" = 100'

18 12 17BA

SEE MAP 18 12 00C

SEE MAP 18 12 00D

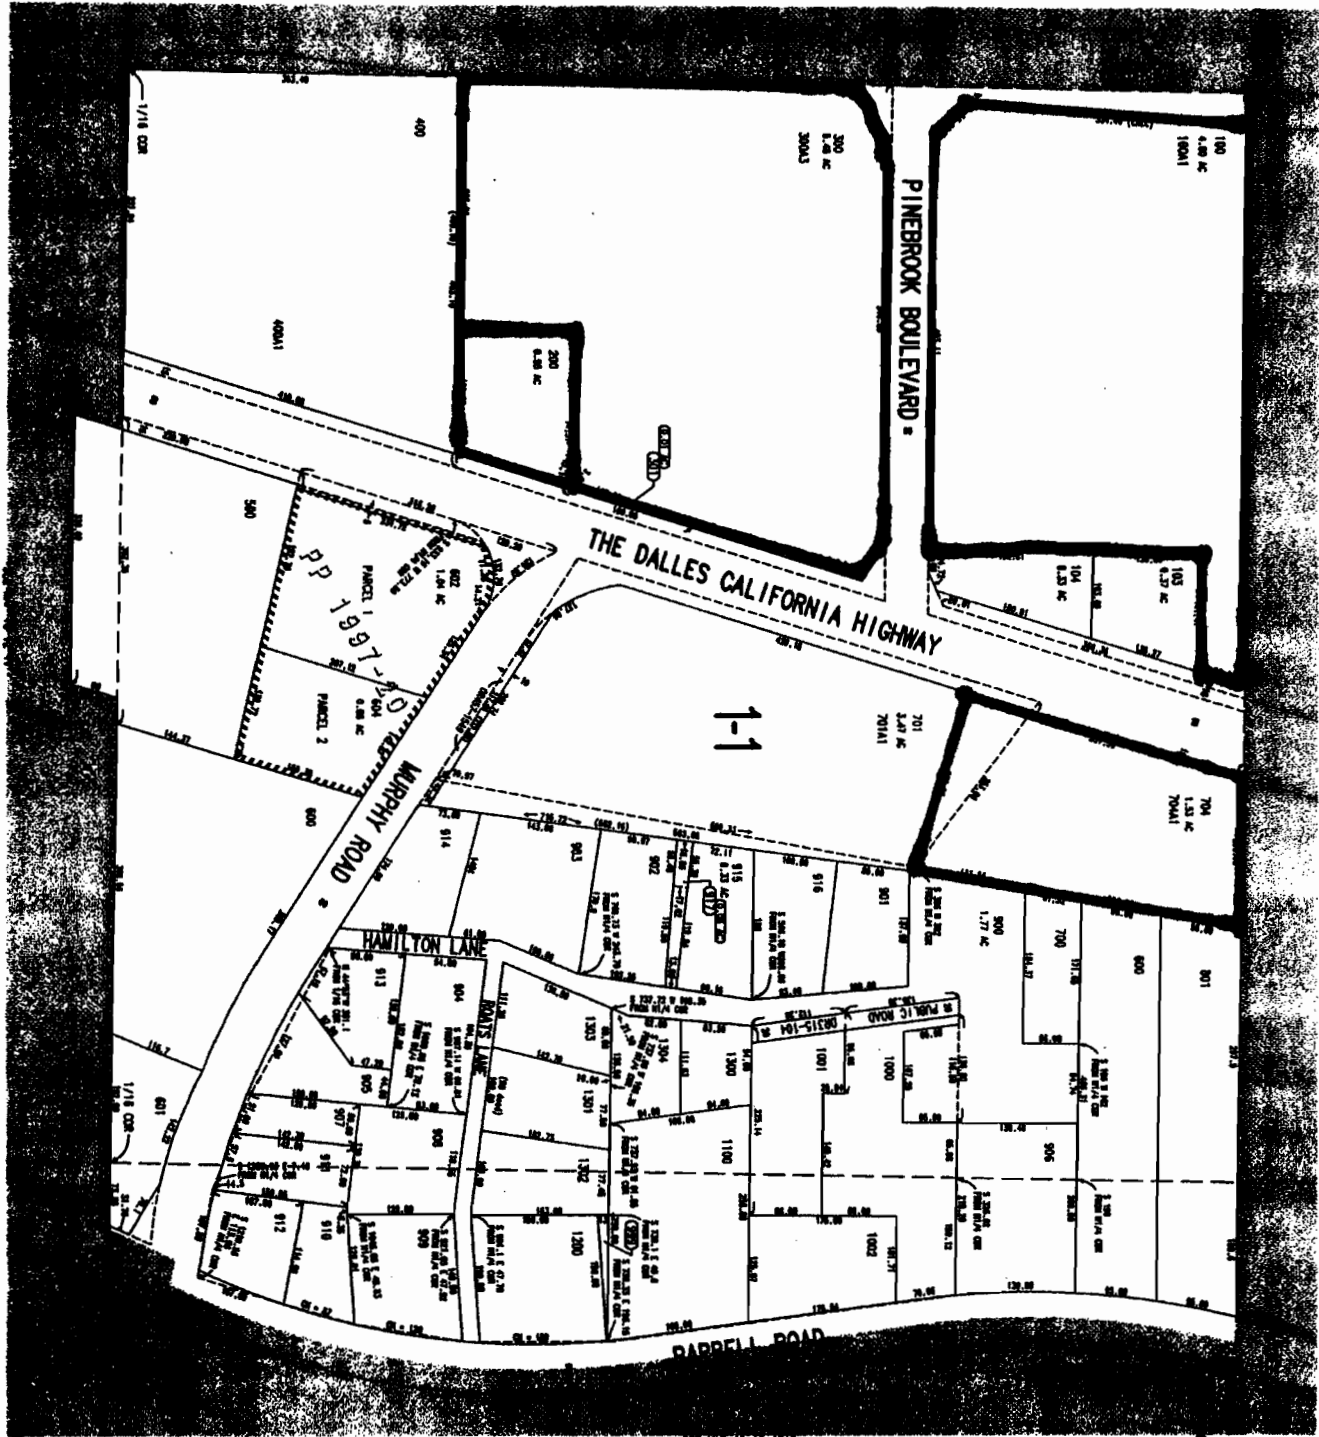


SEE MAP 18 12 17AD

CERTIFICATE NO. 81672  
81658

SEE MAP 18 12 0700

SEE MAP 18 12 070A

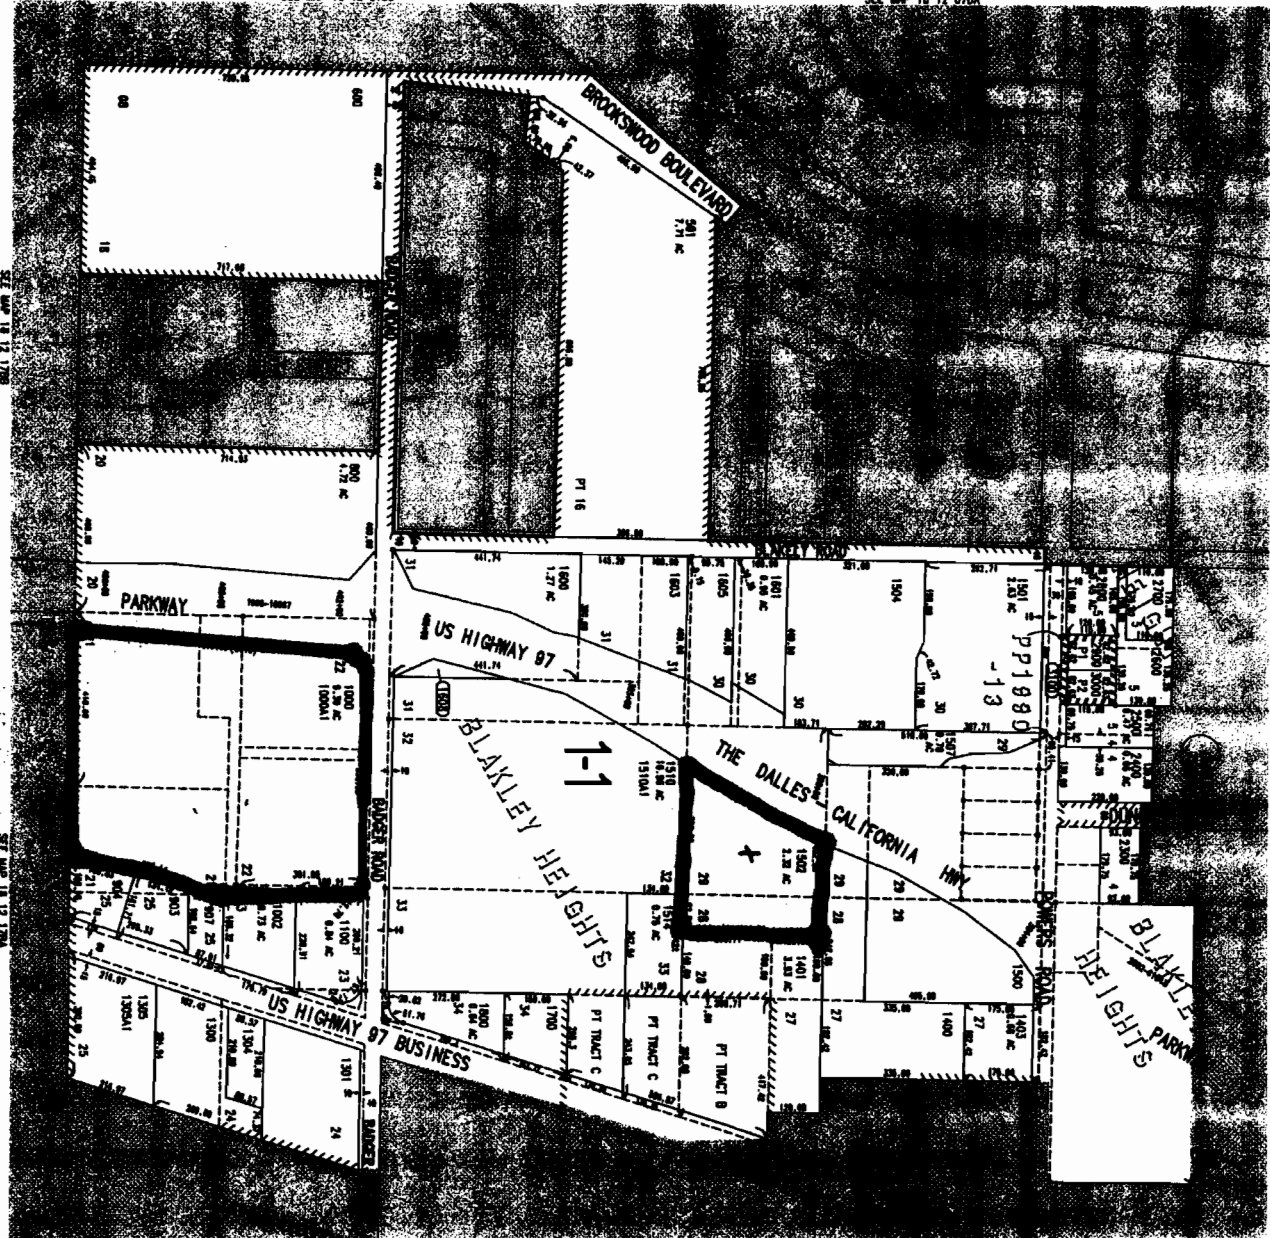

SEE MAP 18 12 08C

SEE MAP 18 12 08B

Controlled Area:  
 100 1/4 Acre 500  
 200 1/4 Acre 500  
8 12 08C  
 & INDEX

