

RECEIVED


SEP 27 2005

WATER RESOURCES DEPT
SALEM, OREGON

Application Map
for
Shotgun Ranch, LLC

T-9908


T.17S., R.20E., W.M.

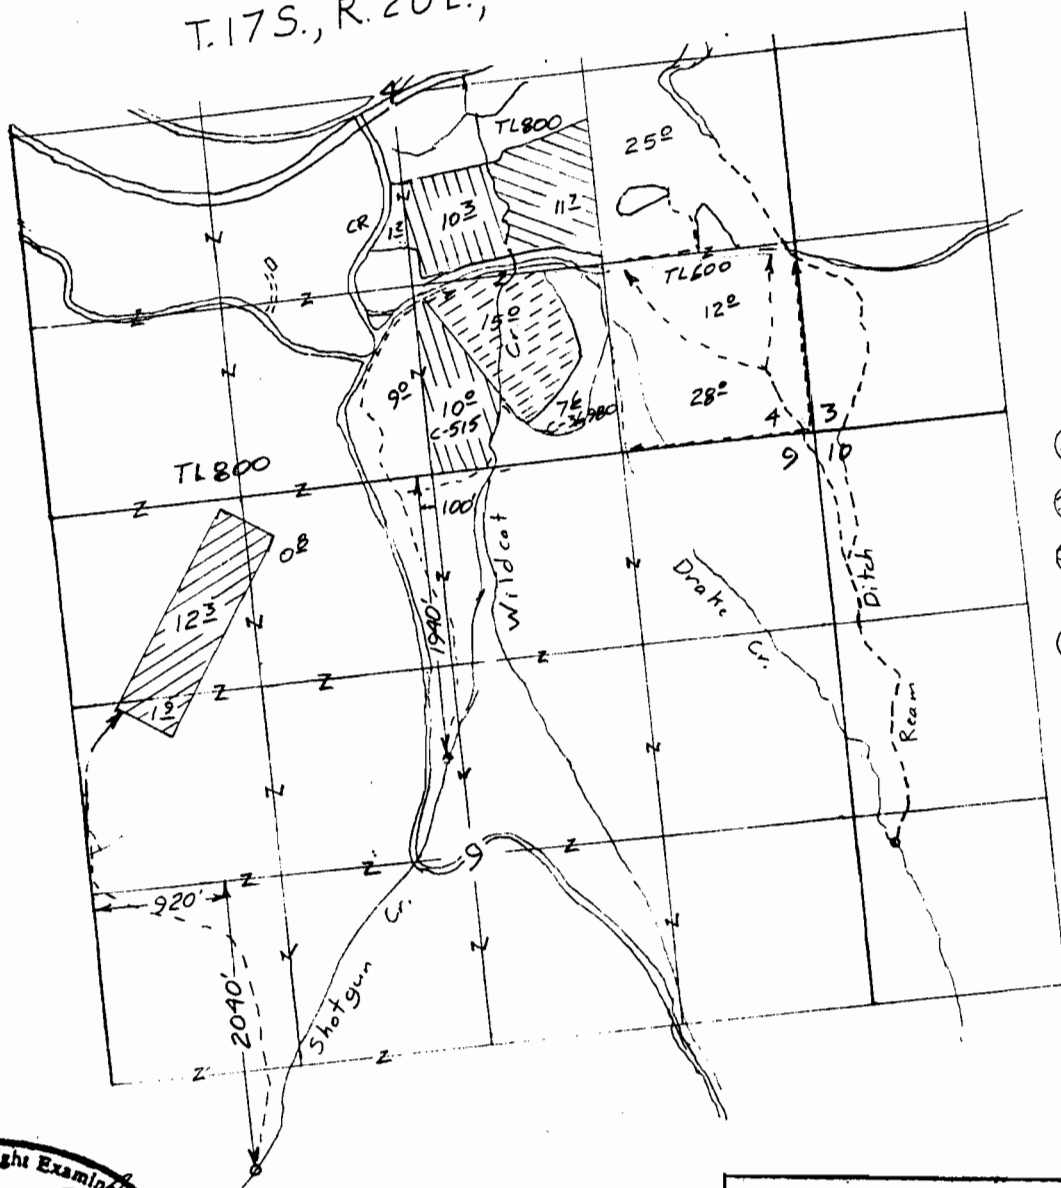

Scale 1"=1320'

C-515

- ⊗ From 15^{ac} (Shotgun Creek)
- ⊗ To 15^{ac}
- ⊗ Drake Cr left in place 11^{ac}
- ⊗ Shotgun Cr. left in place 20^{ac}.

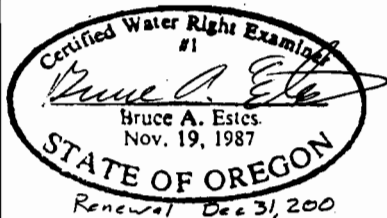

This map is for the purpose of locating a water right only and has no intent to provide legal dimensions or the location of property lines.

ESTES SURVEYS, LLC

PO Box 17519
Salem, OR 97305-7519
(503) 585-7593

60382 Arnold Rd
Bend, OR 97702
(541) 382-7391