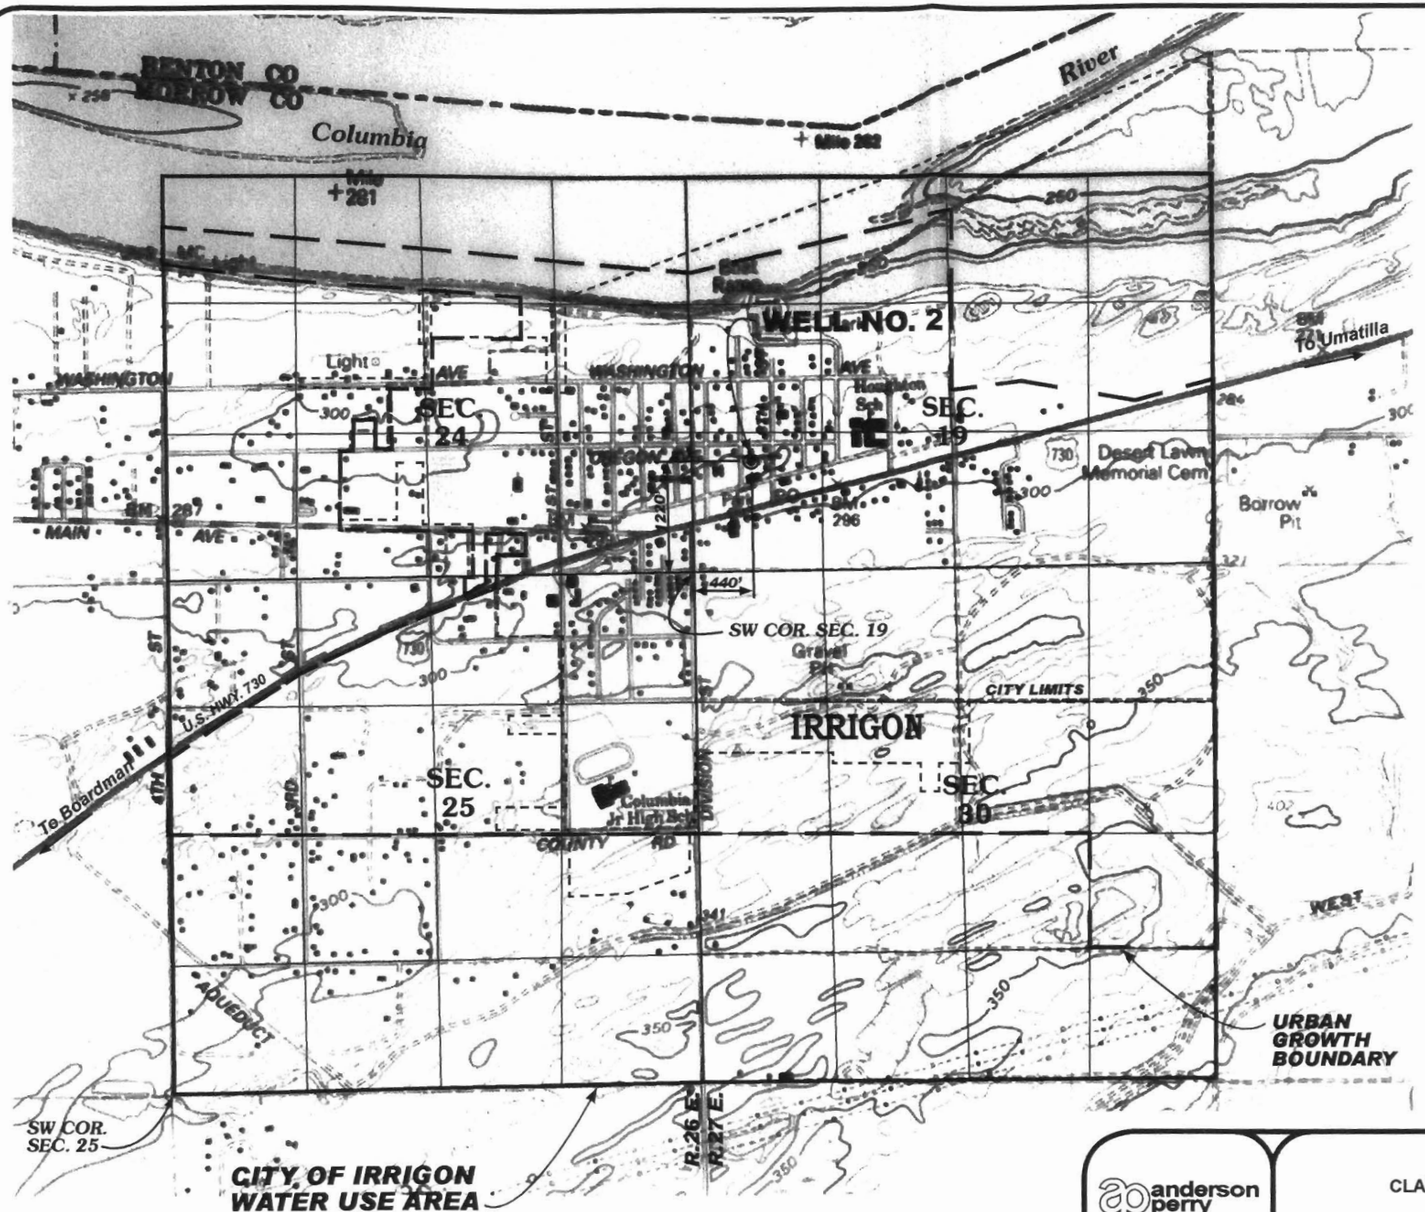

RECEIVED

APR 21 2005

WATER RESOURCES DEPT
SALEM, OREGON

T.5 N., R.26-27 E., W.M.
1"= 1320'

● *POINT OF APPROPRIATION - WELL NO. 2 IS 1220' NORTH AND 440' EAST OF THE SW CORNER OF SECTION 19.*

PLACE OF USE

CITY OF IRRIGON WATER USE AREA

T.5 N., R.26 E.

SEC 24	SEC 25
SW 1/4 NE 1/4	NE 1/4
SE 1/4 NE 1/4	NW 1/4
SW 1/4 NW 1/4	SW 1/4
SE 1/4 NW 1/4	SE 1/4
SW 14	
SE 1/4	

T.5 N., R.27 E.

SEC 19	SEC 30
SW 1/4 NE 1/4	NE 1/4
SE 1/4 NE 1/4	NW 1/4
SW 1/4 NW 1/4	SW 1/4
SE 1/4 NW 1/4	SE 1/4
SW 14	
SE 1/4	

Certified Water Rights Examiner
657868
Michael B. Posada
June 8, 1999
STATE OF OREGON

EXPIRATION DATE: 12-31-06

DATED: 9-18-2005

NOTE:
THIS MAP IS FOR THE PURPOSE OF LOCATING A WATER RIGHT ONLY AND IS NOT INTENDED TO PROVIDE LEGAL DIMENSIONS OR LOCATIONS OF PROPERTY LINES.

LAST REVISION: JANUARY 5, 2005

anderson perry & associates, inc.

CITY OF
IRRIGON, OREGON
CLAIM OF BENEFICIAL USE MAP

PERMIT NOS. G-7241
APPLICATION NOS. G-7703

FIGURE
1

J# 910-61-217