


SECTIONS 25 & 36, TWP.2 N. RANGE 20 E. AND
 SECTIONS 19, 30 & 31, TWP.2 N. RANGE 21 E. W.M.

GILLIAM COUNTY, OREGON

RECEIVED

OCT - 3 1994

WATER RESOURCES DEPT.
 SALEM, OREGON

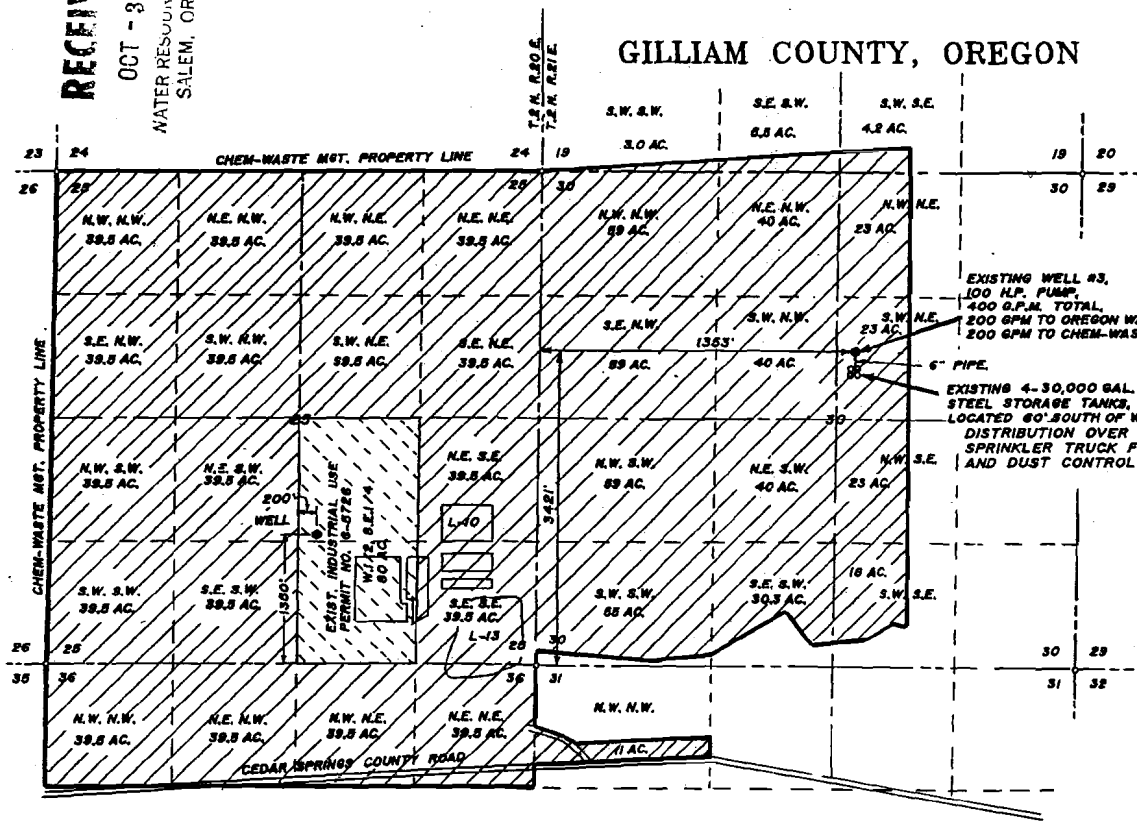

FINAL PROOF SURVEY

SCALE: 1" = 1320'

PERMIT No. T-6740 (G-8547)
 G-11667

IN THE NAME OF:
 CHEM-WASTE MGT. OF THE NORTHWEST


DATE: SEPTEMBER 20, 1994

BY: TENNESON ENGINEERING CORP.
 409 LINCOLN STREET,
 THE DALLES, OREGON. 97058
 PH. (503) 296-9177



INDUSTRIAL USE AREA, 1204 ACRES TOTAL.
 0.4464 C.F.S. NOW COVERED DURING IRRIGATION SEASON ONLY
 UNDER PERMITS G-8547 & T-6740 WITH THESE RIGHTS
 SUPPLEMENTAL TO P-11667 COVERAGE.

EXISTING INDUSTRIAL USE AREA, PERMIT G-5726, (UNCHANGED)

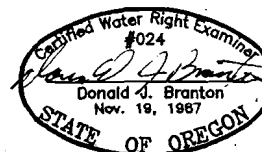

NOTE:

"THIS MAP IDENTIFIES THE LOCATION OF
 THE WATER RIGHT ONLY AND IS NOT
 INTENDED TO PROVIDE DIMENSIONS OR
 LOCATE PROPERTY OWNERSHIP LINES."

W.O. #7750