


T.29S.R. 7W.W.M.

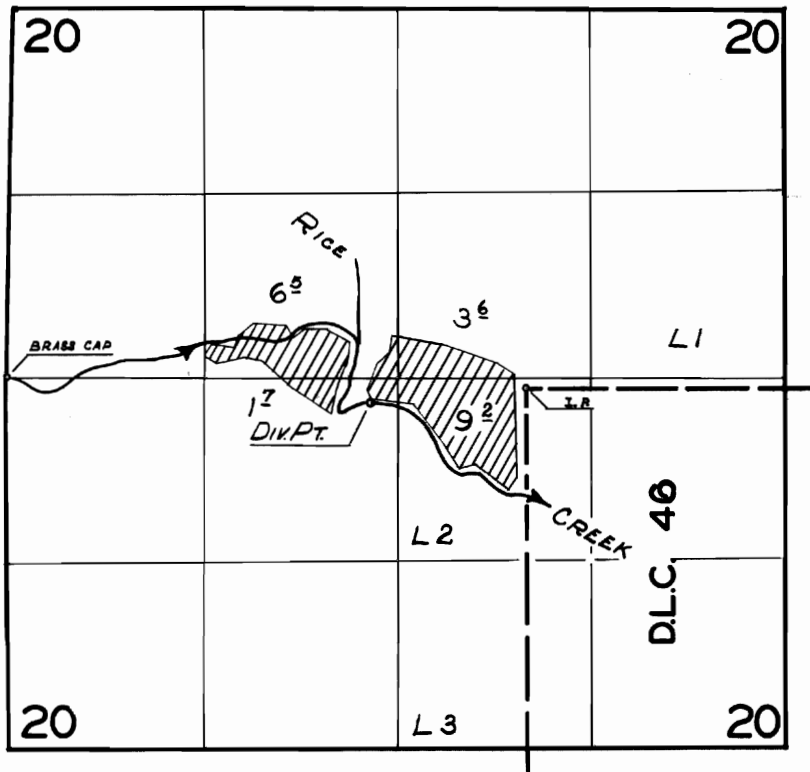

**FINAL PROOF SURVEY**  
UNDER

Application No. 28129 Permit No. 22141  
IN NAME OF

ELTON J. ZUVER

Surveyed AUGUST 31 1961, by C.O. BARTELS