


**FINAL PROOF MAP**  
**SW1/4NW1/4 Section 3, T. 39 S., R. 3 W., W.M.**  
**Jackson County, Oregon**  
 For  
**Donald M. and Julia M. Hoskins**  
**2076 Upper Applegate Road**  
**Jacksonville, OR. 97530**

**RECEIVED**  
**AUG 25 2005**  
**WATER RESOURCES DEPT**  
**SALEM, OREGON**

Township 39 South, Range 3 West

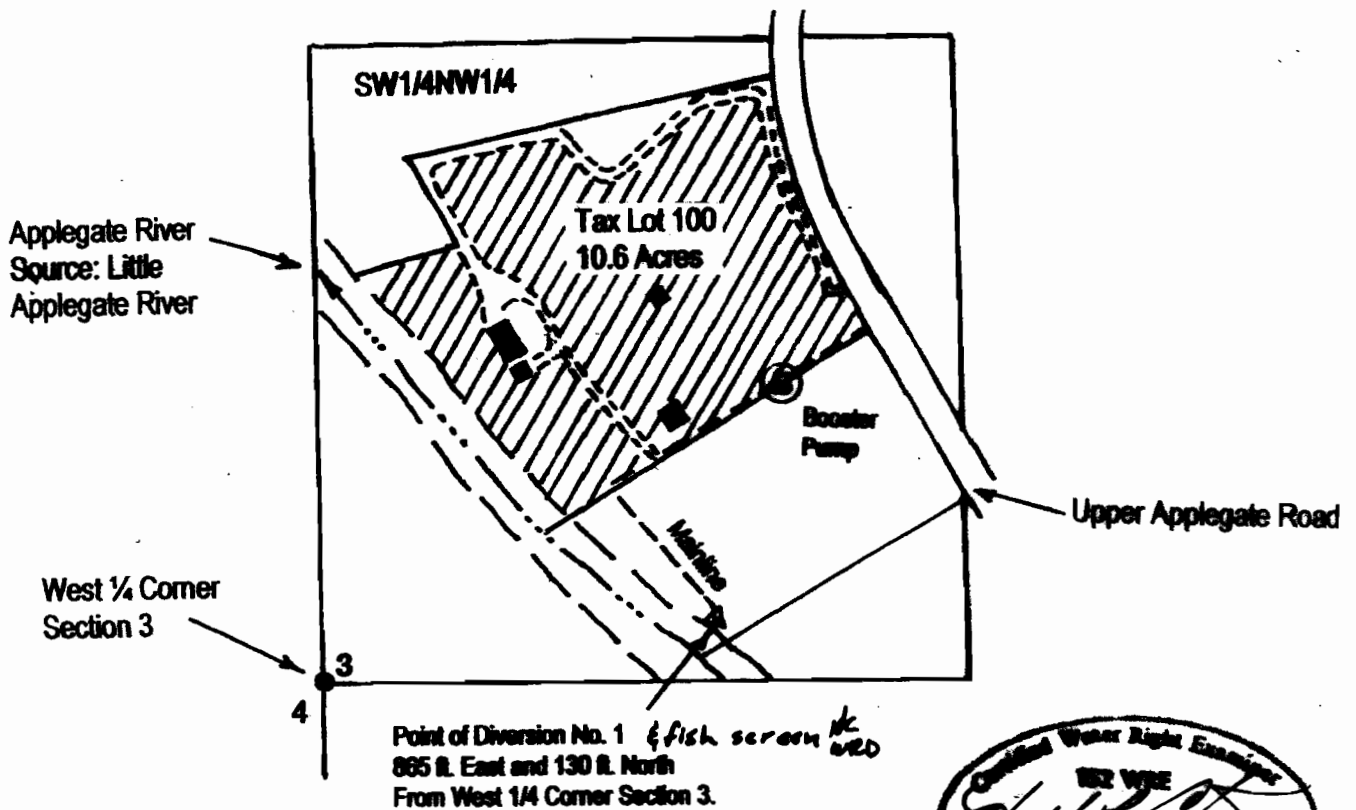

**LEGEND**

North

Date: June 29, 2005

Scale: 1" = 400'

- Found Survey Monument
- Denotes Building




Denotes area under Special Order  
 Volume 59, Pages 421-424, Priority  
 Date September 1, 1857.

**Certified Water Right Examiner**  
**HAROLD L. CENTER, P.L.S., C.W.R.E.**  
 2804 David Lane - Medford, OR. 97504  
 541-535-6188, Fax 541-535-8752  
 Oregon C.W.R.E. No. 152  
 Certificate Renewal Date, 12/31/05

This map was prepared for the purpose of identifying the location of a water right only and is not intended to provide legal dimensions or location of property ownership.

# T 39 S, R 3 W, W.M.

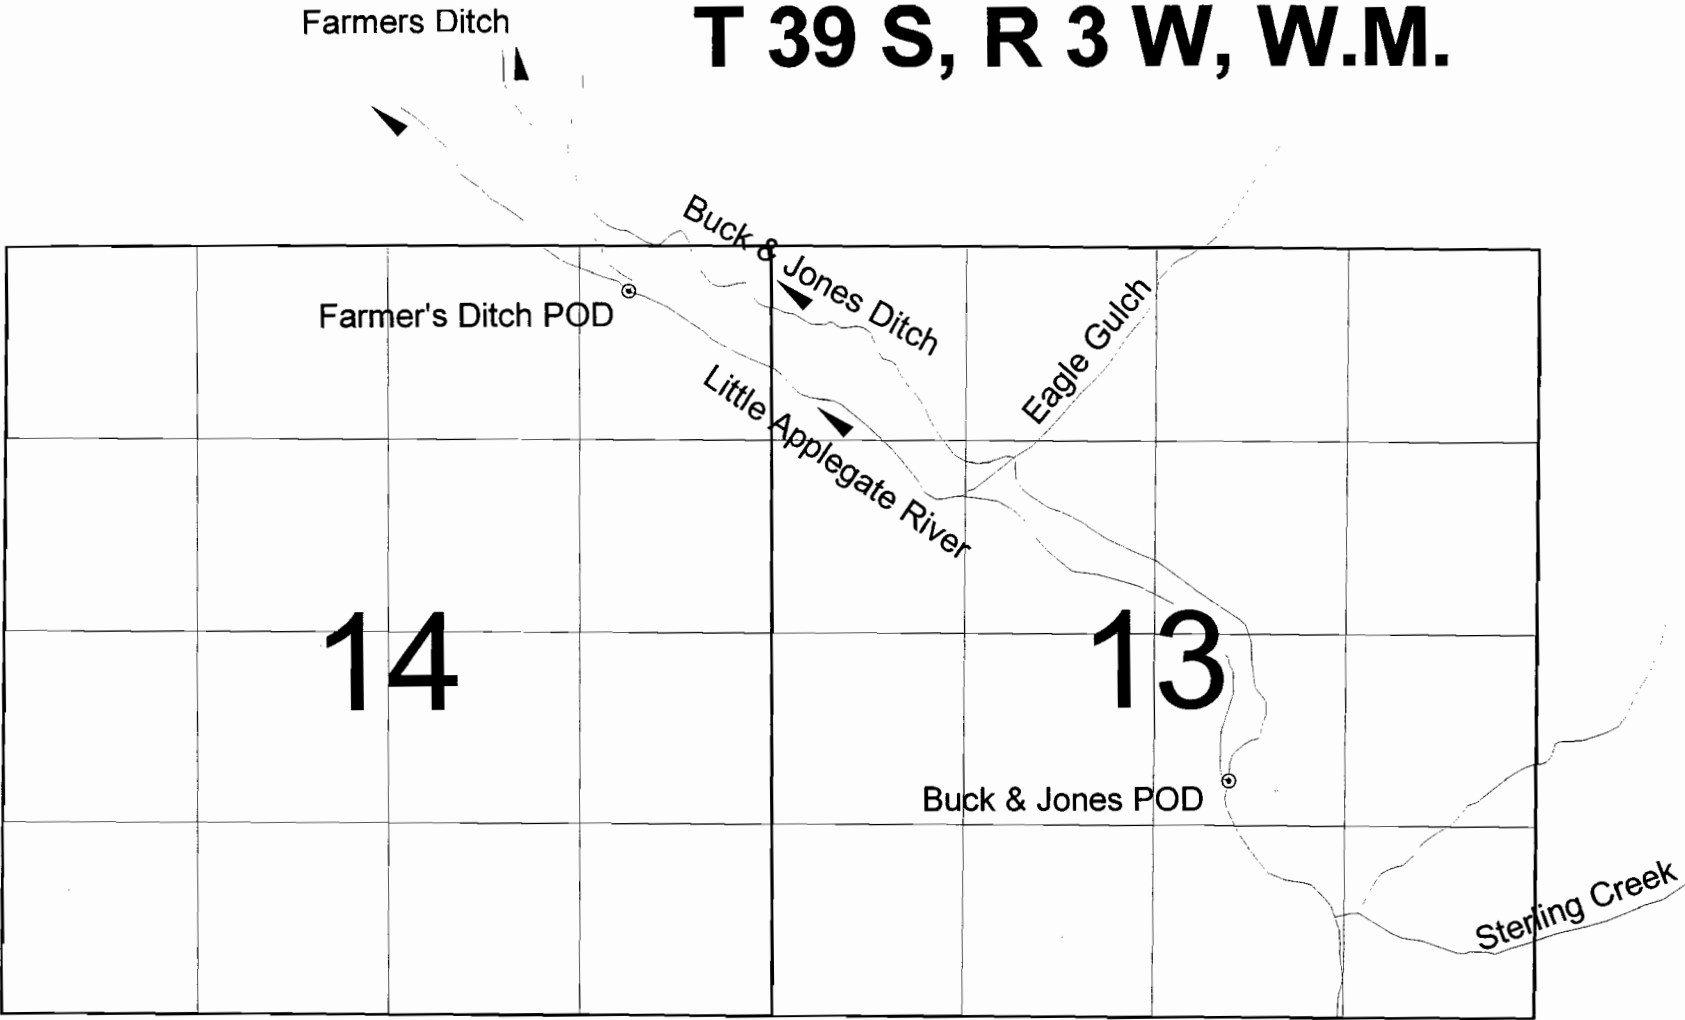

Farmers Ditch

Farmer's Ditch POD

Buck & Jones Ditch

Eagle Gulch

Little Applegate River

14

13

Buck & Jones POD

Sterling Creek

Final Proof Survey  
under

T-8953

Little Applegate River



Farmer's Ditch POD - GPS coordinates: Longitude 42.18400, Latitude -123.0174  
Buck & Jones Ditch POD - GPS coordinates: Longitude 42.17508, Latitude -123.0018

0 0.5 1 Miles



Scale 1 inch = 1320 feet