


FINAL PROOF MAP
SW1/4NW1/4 Section 3, T. 39 S., R. 3 W., W.M.
Jackson County, Oregon
 For
John J. Ducey
2220 Upper Applegate Road
Jacksonville, OR. 97530

RECEIVED

AUG 08 2005

**WATER RESOURCES DEPT
 SALEM, OREGON**

Township 39 South, Range 3 West

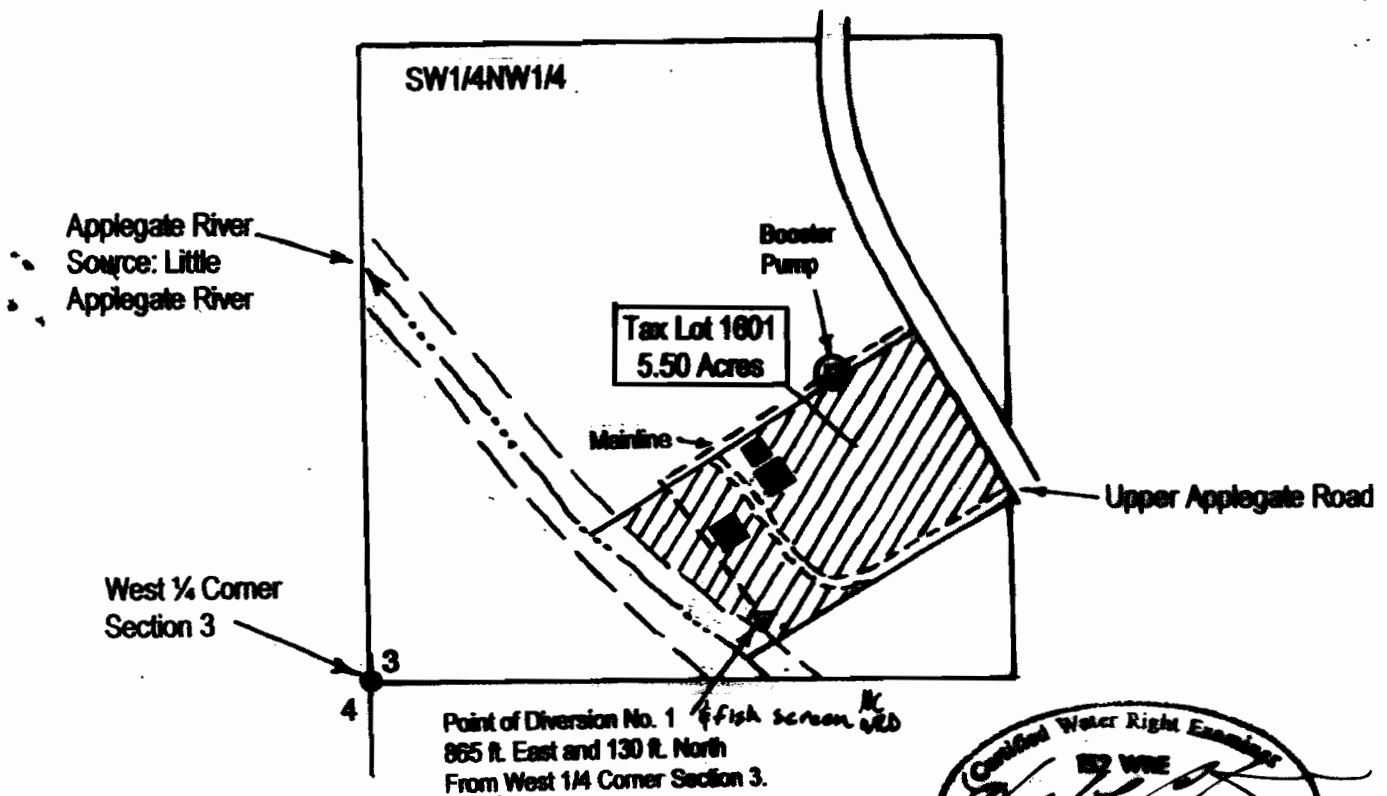

LEGEND



North

Date: June 29, 2005

Scale: 1" = 400'

- Found Survey Monument
- Denotes Building




Denotes area under Special Order
 Volume 59, Pages 390-393, Priority
 Date September 1, 1857.

Certified Water Right Examiner
HAROLD L. CENTER, P.L.S., C.W.R.E.
 2884 David Lane - Medford, OR. 97504
 541-535-6188, Fax 541-535-8752
 Oregon C.W.R.E. No. 182
 Certificate Renewal Date, 12/31/05

This map was prepared for the purpose of identifying the location of a water right only and is not intended to provide legal dimensions or location of property ownership.

T 39 S, R 3 W, W.M.

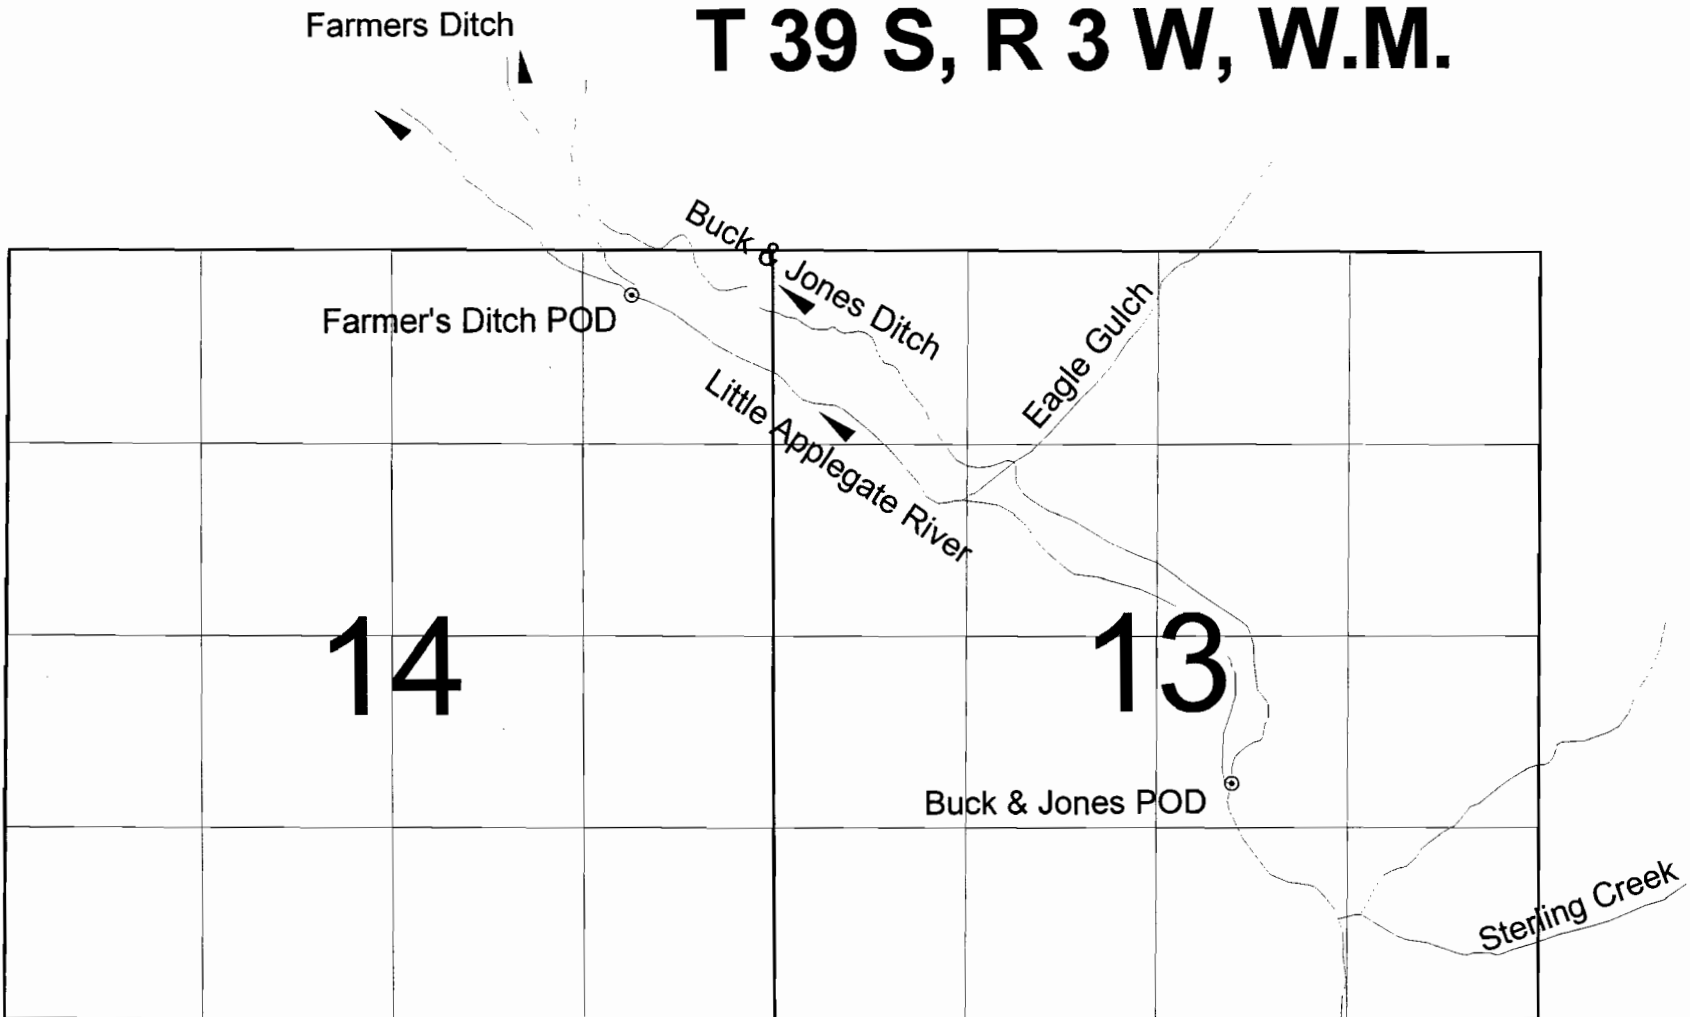

Final Proof Survey
under
T-8954



Farmer's Ditch POD - GPS coordinates: Longitude 42.18400, Latitude -123.0174
Buck & Jones Ditch POD - GPS coordinates: Longitude 42.17508, Latitude -123.0018

