


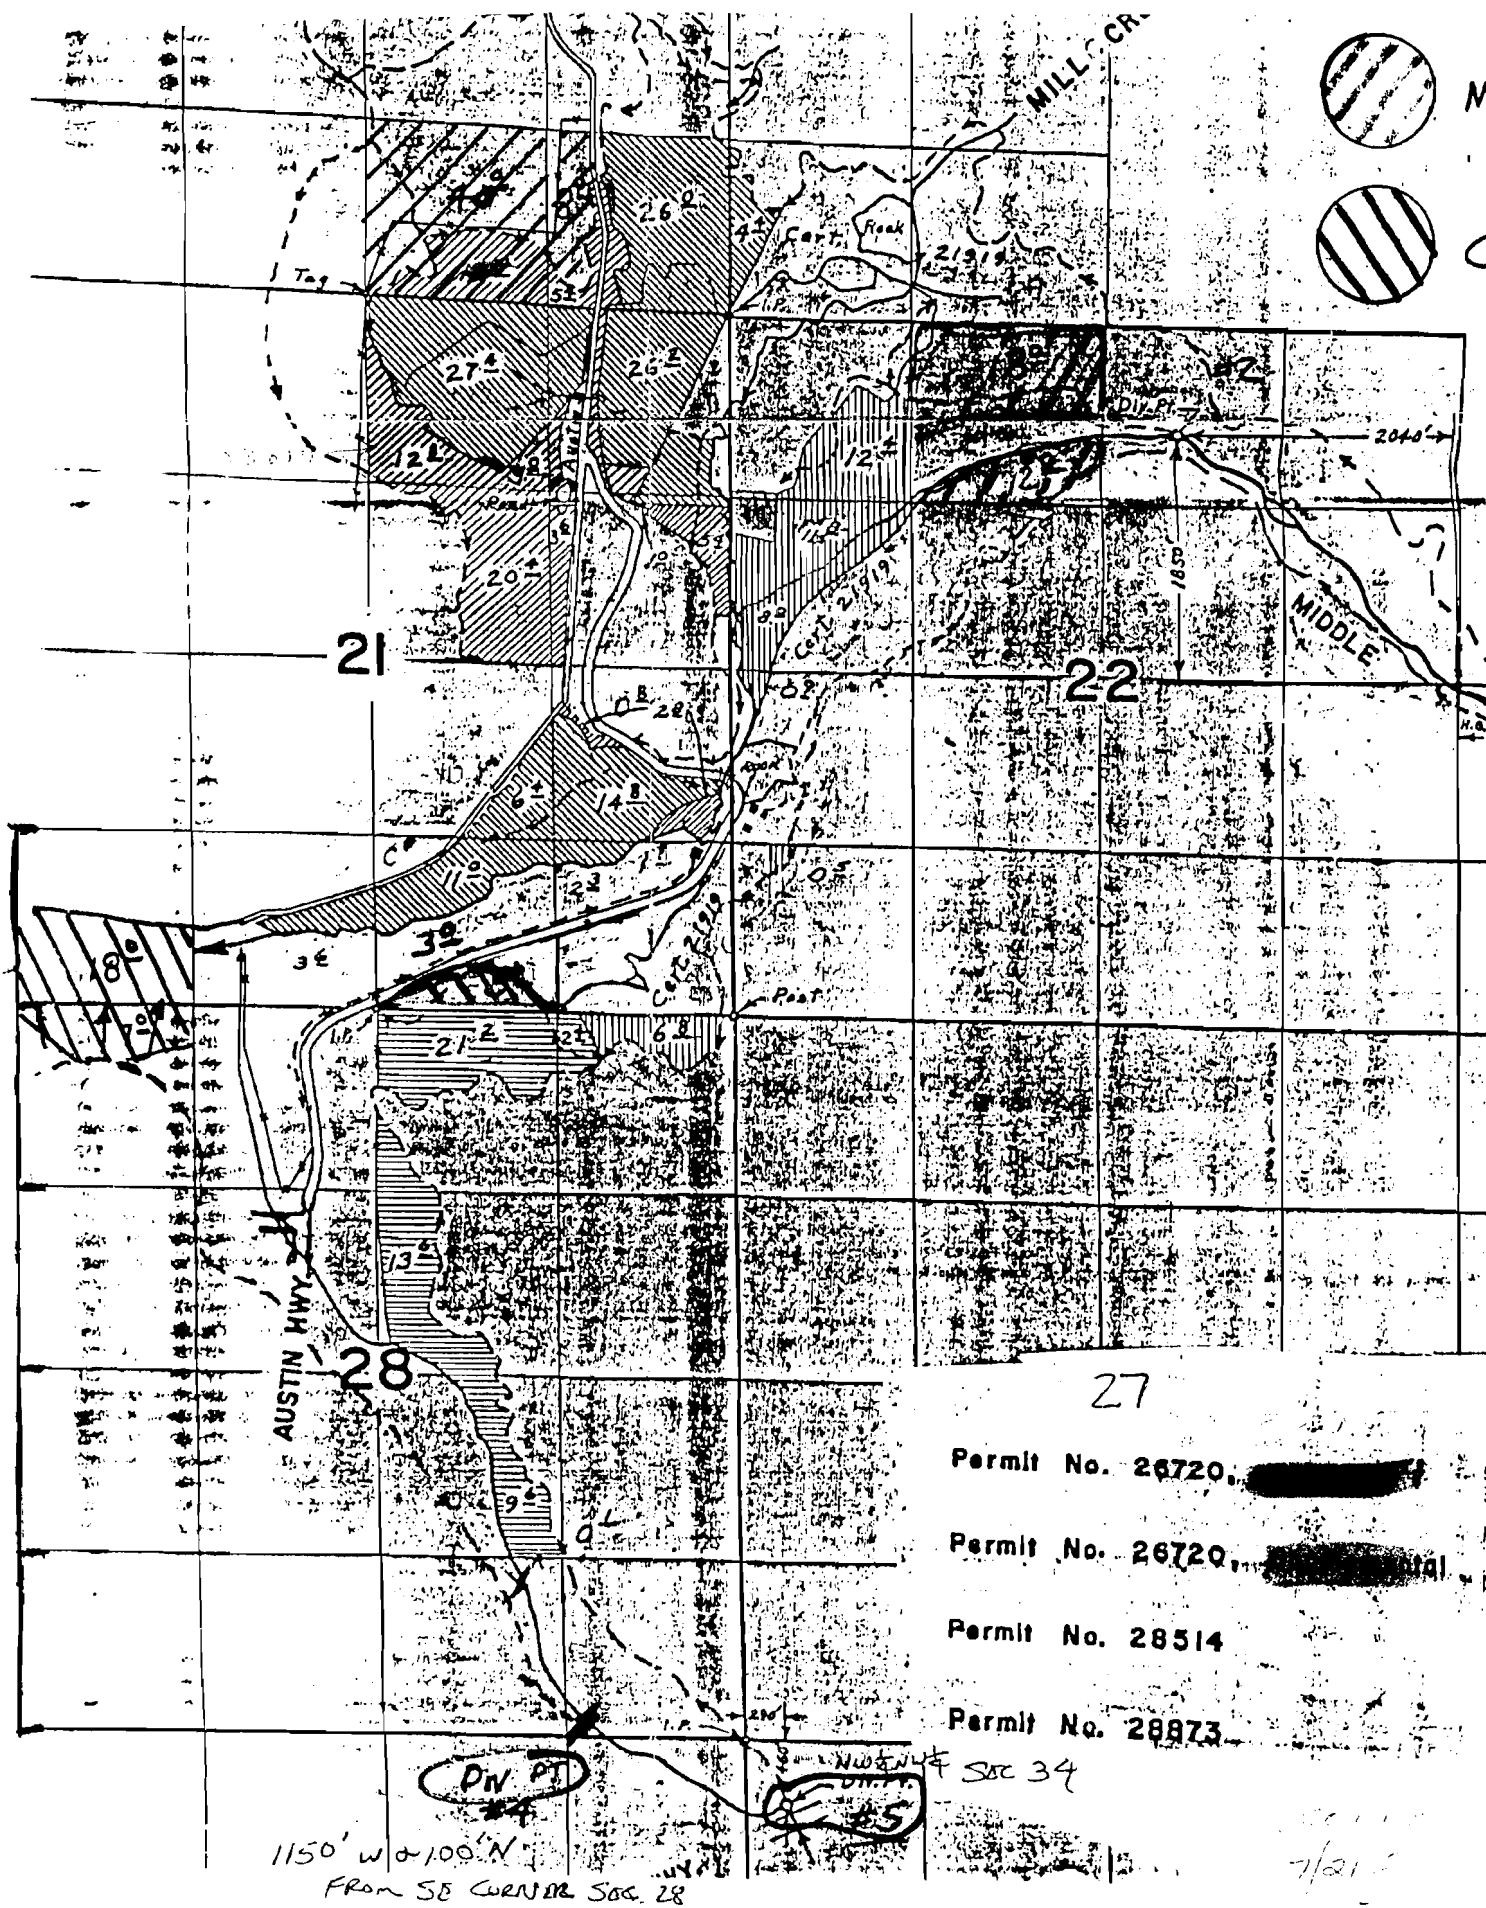

Permit No. 26720, [REDACTED]

Permit No. 26720, [REDACTED]

Permit No. 28514


W 1/4 SEC 34

7/21