


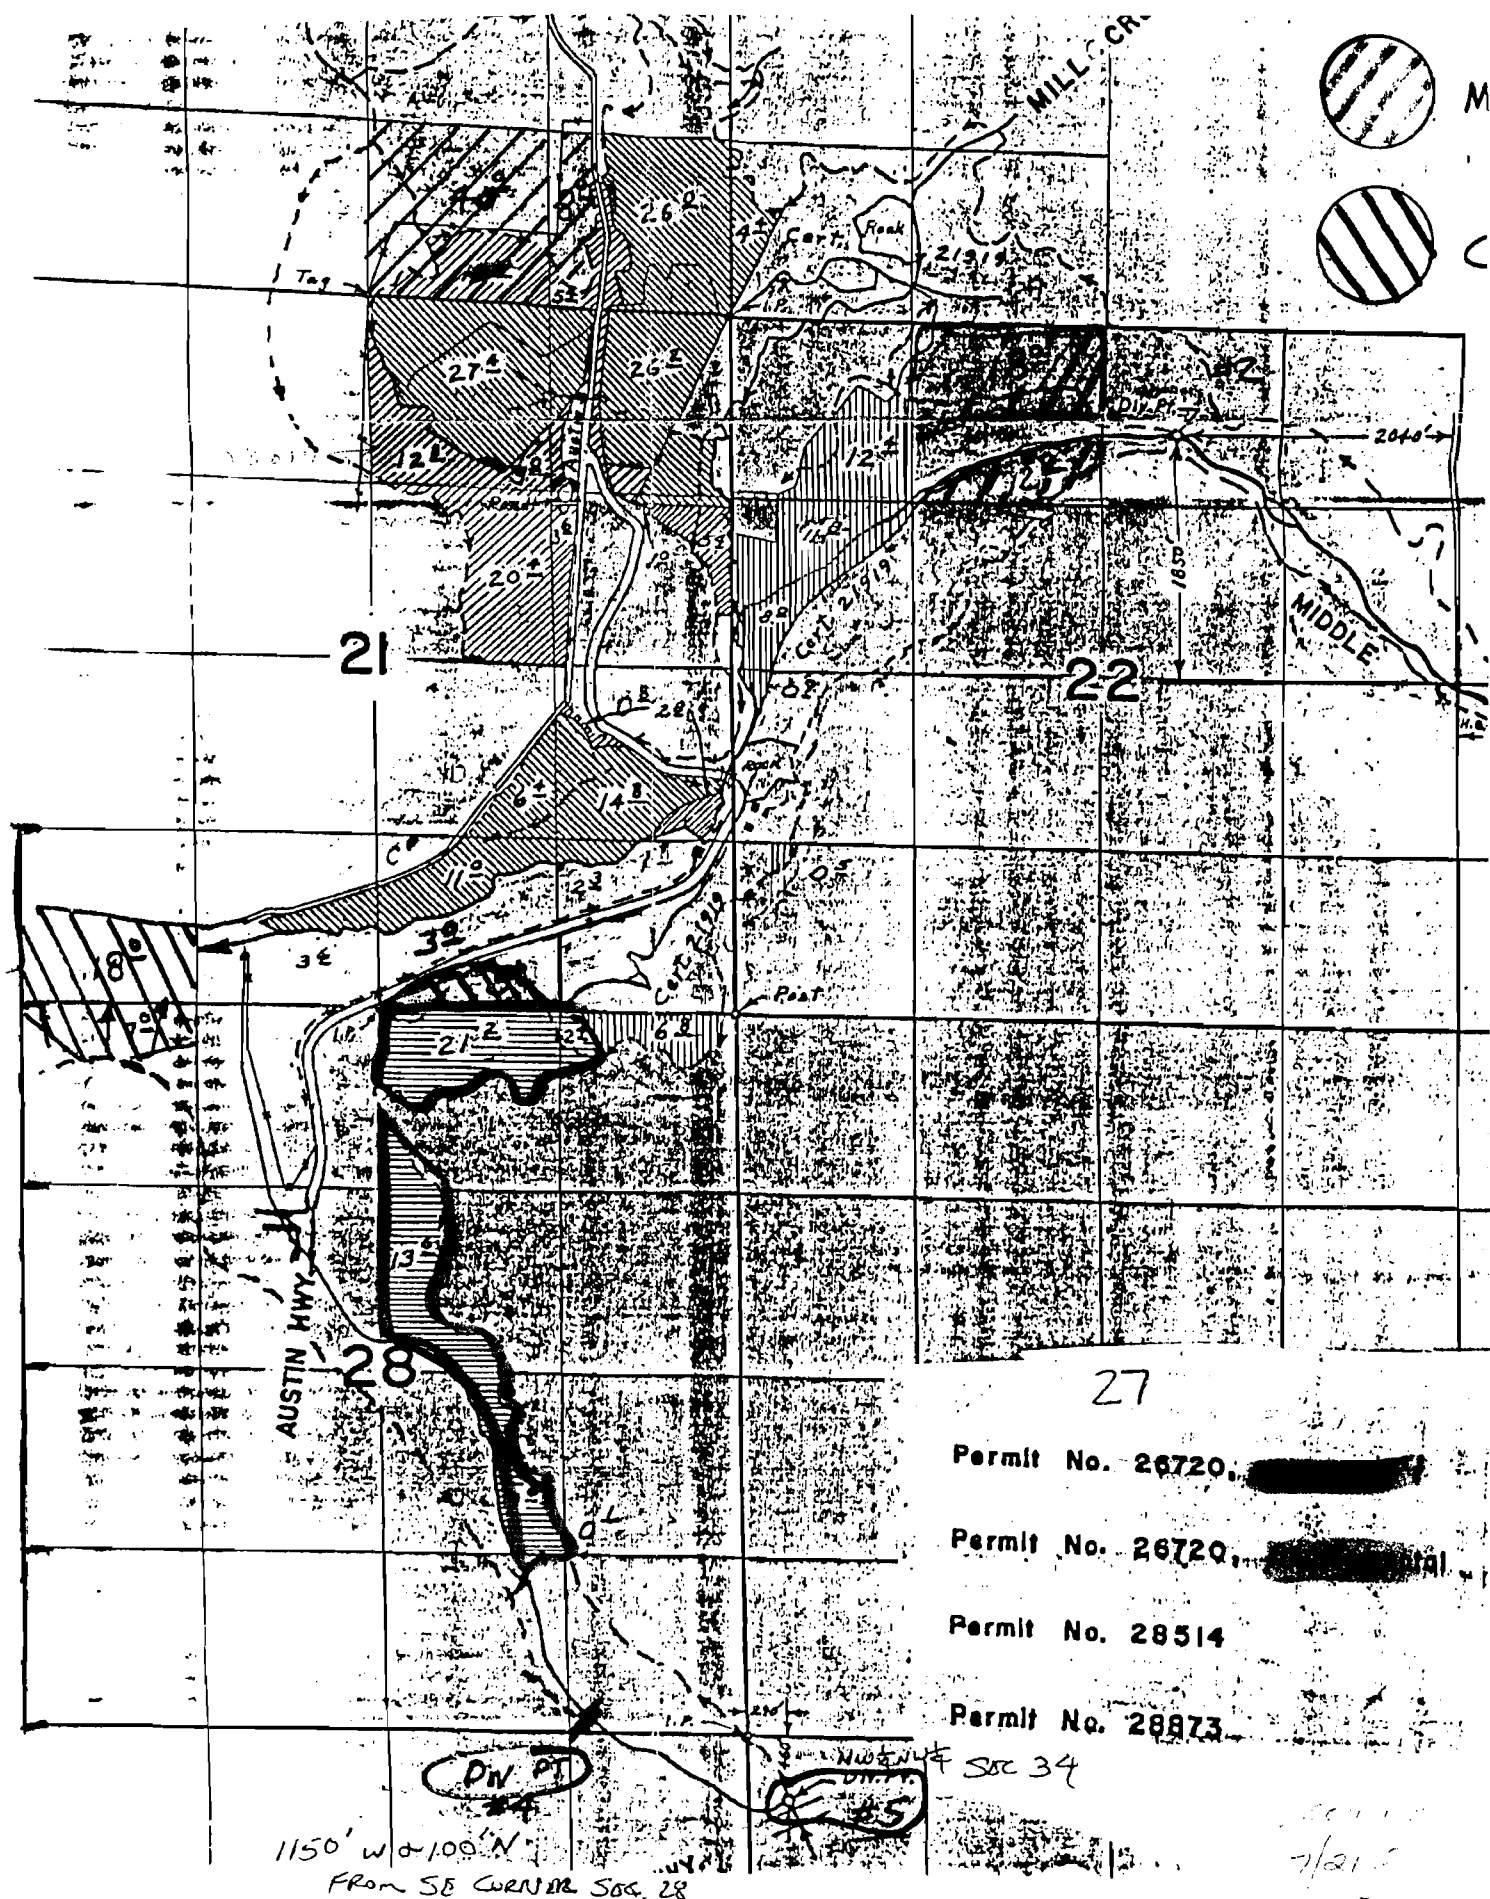

Permit No. 26720. [REDACTED]

Permit No. 26720. [REDACTED]

Permit No. 28514

Permit No. 28873

SEC 34

1150' W & 100' N
FROM SE CORNER SEC. 28

7/21/57