


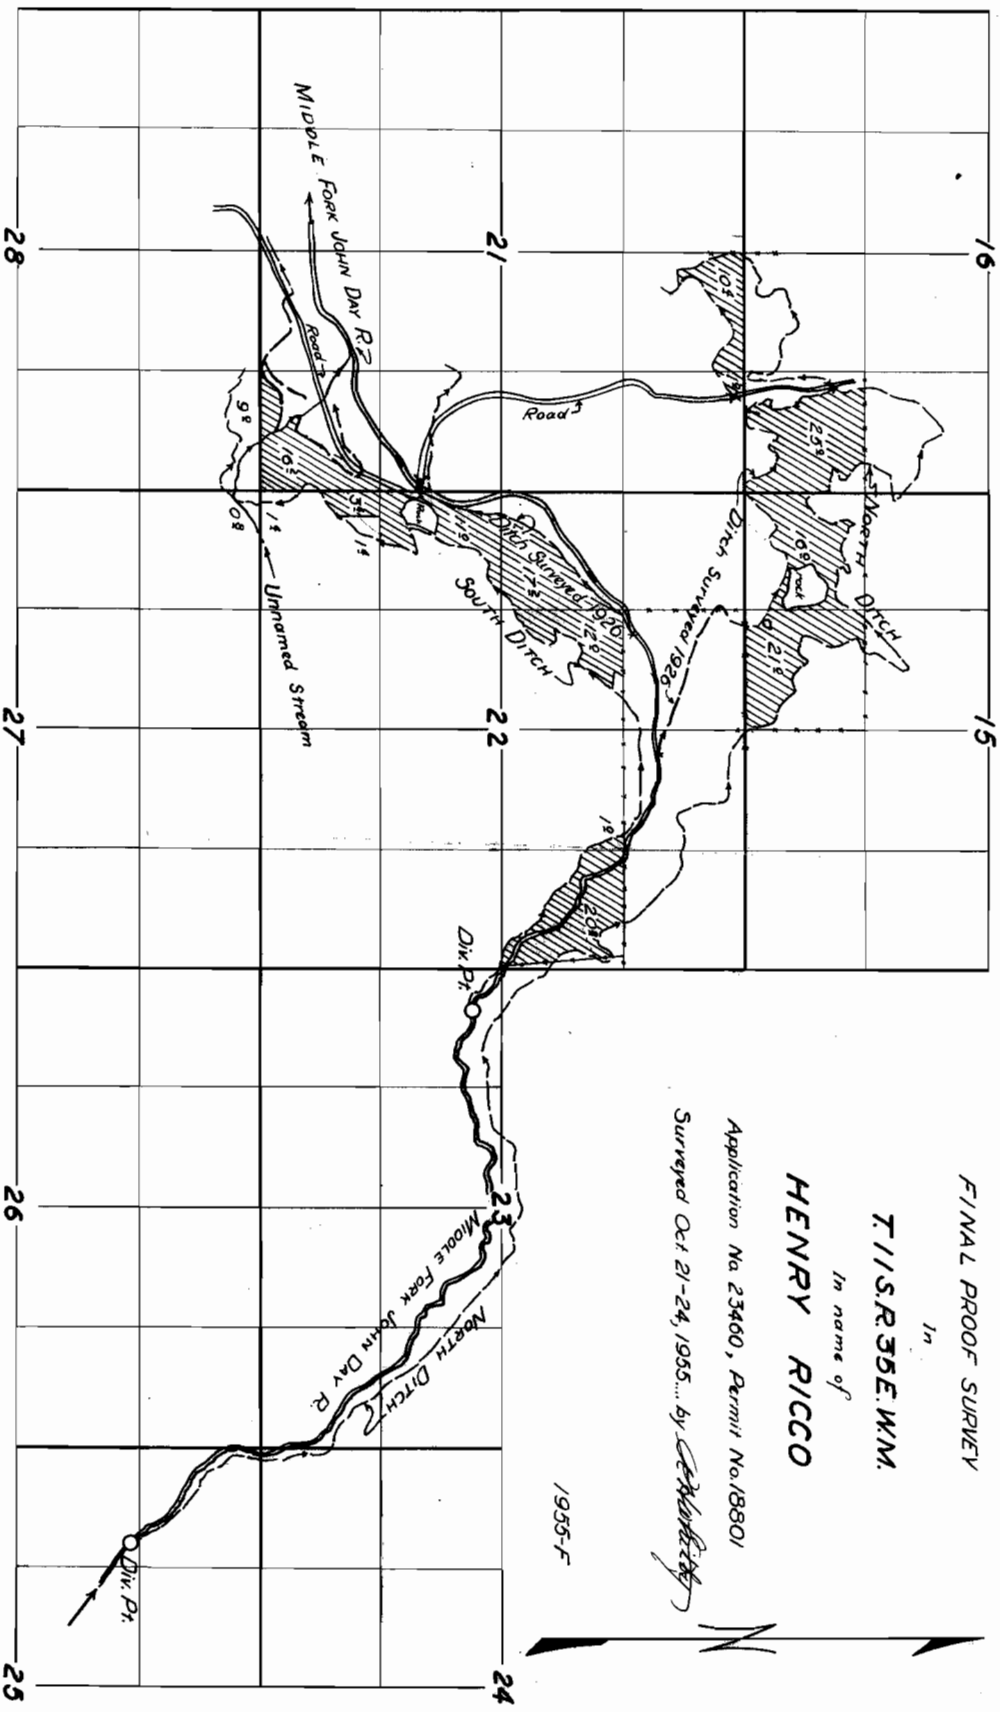

FINAL PROOF SURVEY

In

T.I.S.R. 35E. W.M.

In name of

HENRY RICCO

Application No. 23460, Permit No. 18801

Surveyed Oct. 21-24, 1955... by *C. H. H. H. H.*

1955-F