

C-72346

NOT PARTICIPATING in Transfer


IND

Cancel
Canton
0.70 AC

100
1.00Ac.

RIVER

CHEWAUCAN

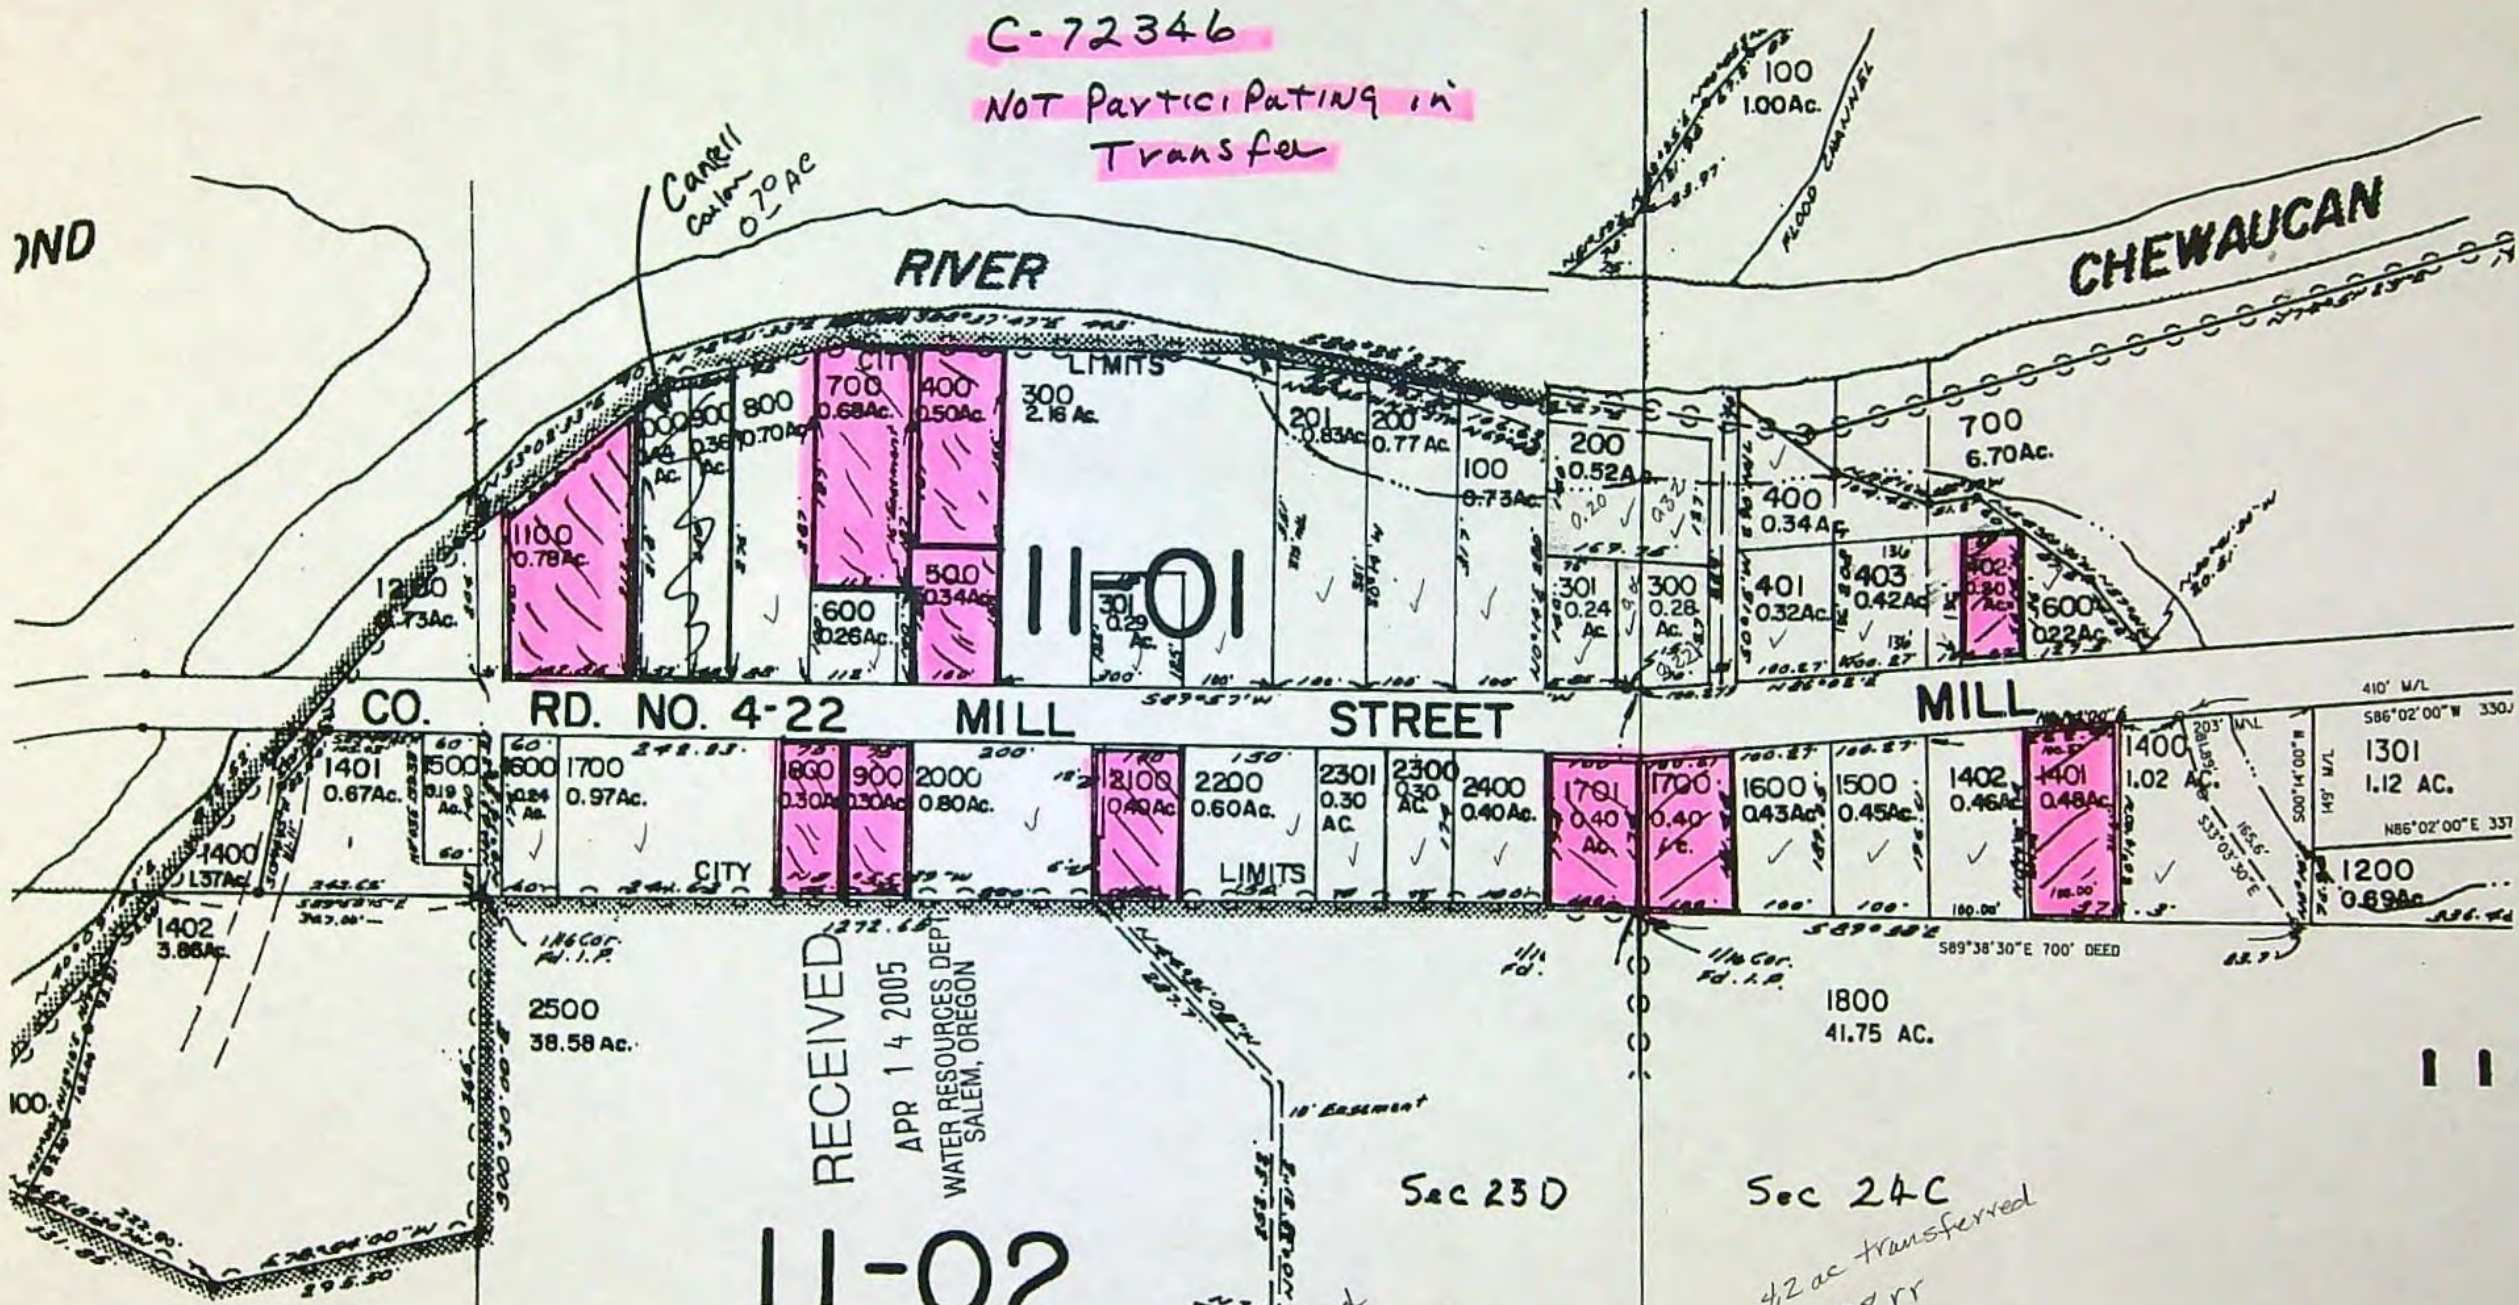

11-02

RECEIVED
APR 14 2005
WATER RESOURCES DEPT
SALEM, OREGON

Sec 23D

Sec 24C

9.85 transferred

0.70 cancel?
10.55 - 50 1.45ac rr

4.2 ac transferred
50 0.8 rr

Under Proof 129
+ All of Proof 131