


Water Right Transfer Certificate 32728 T 36 S, R 2 W, Sec 11 and 14, W.M.

RECEIVED
WATER RESOURCES
DIVISION
STATE OF OREGON

Change in Place of Use, Point of Diversion and Type of use

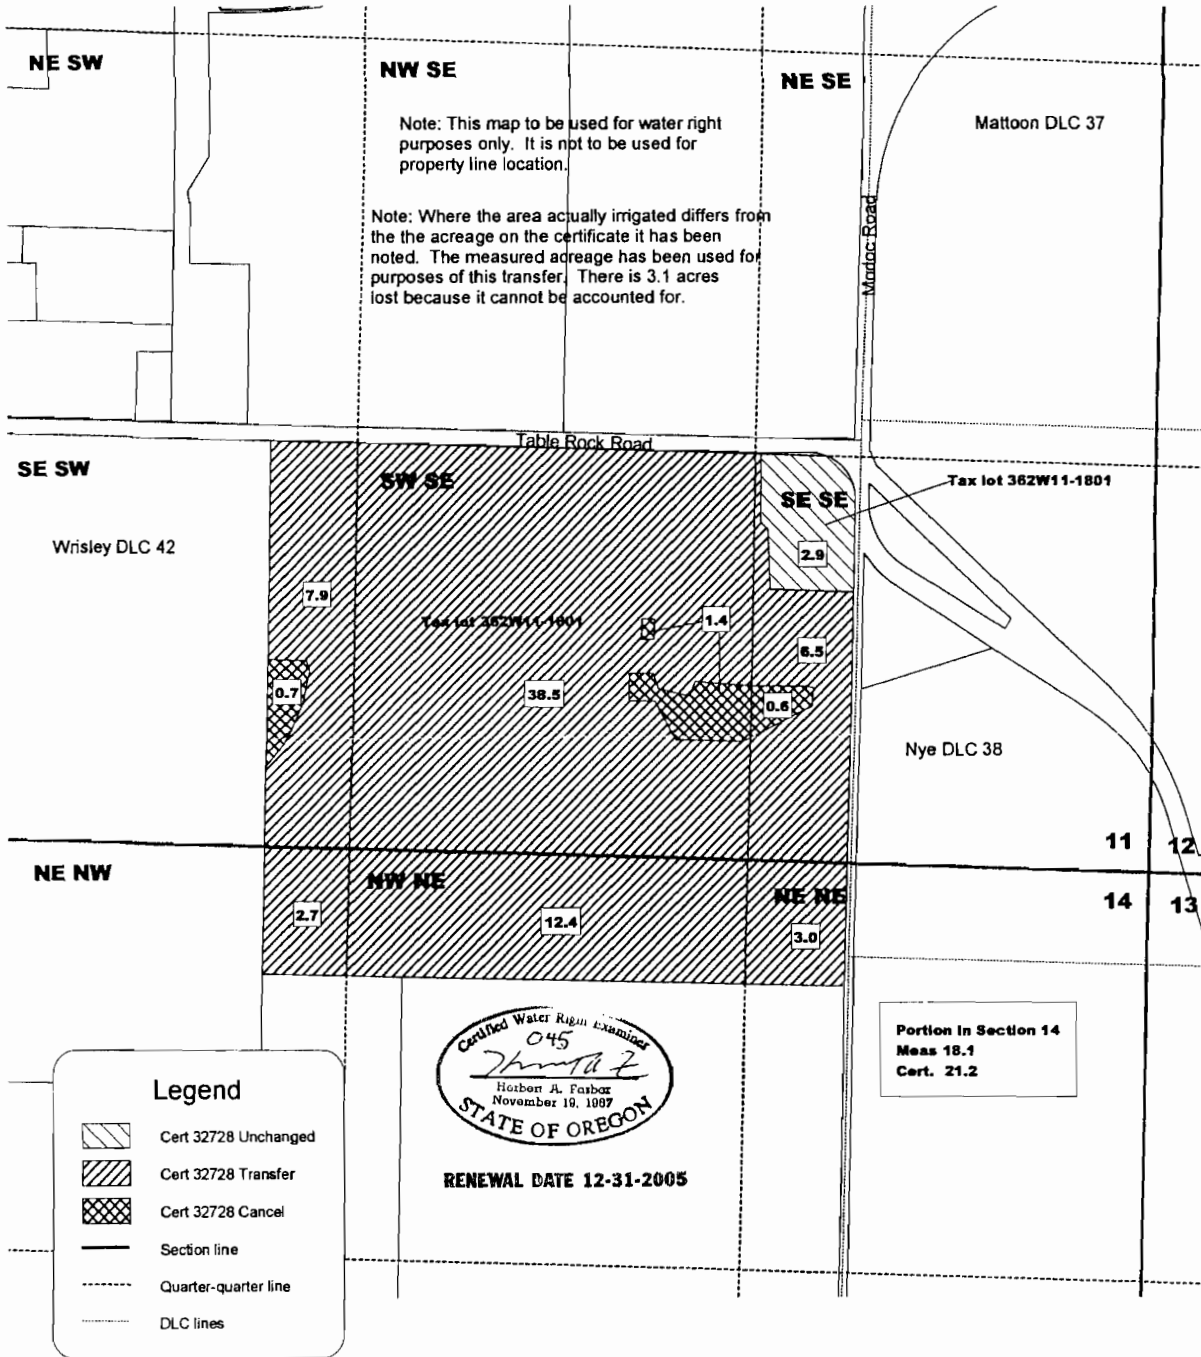

FARBER SURVEYING
 PO Box 5286 Farber & Sons, Inc.
 Central Point, Oregon 97502 431 Oak Street
 Phone 541-664-5599 Central Point, Oregon
 Fax 541-664-5603
 Email hfarber@charter.net Tax ID: 93-1057173

