



# T. 1N. R. 13E. W.M.

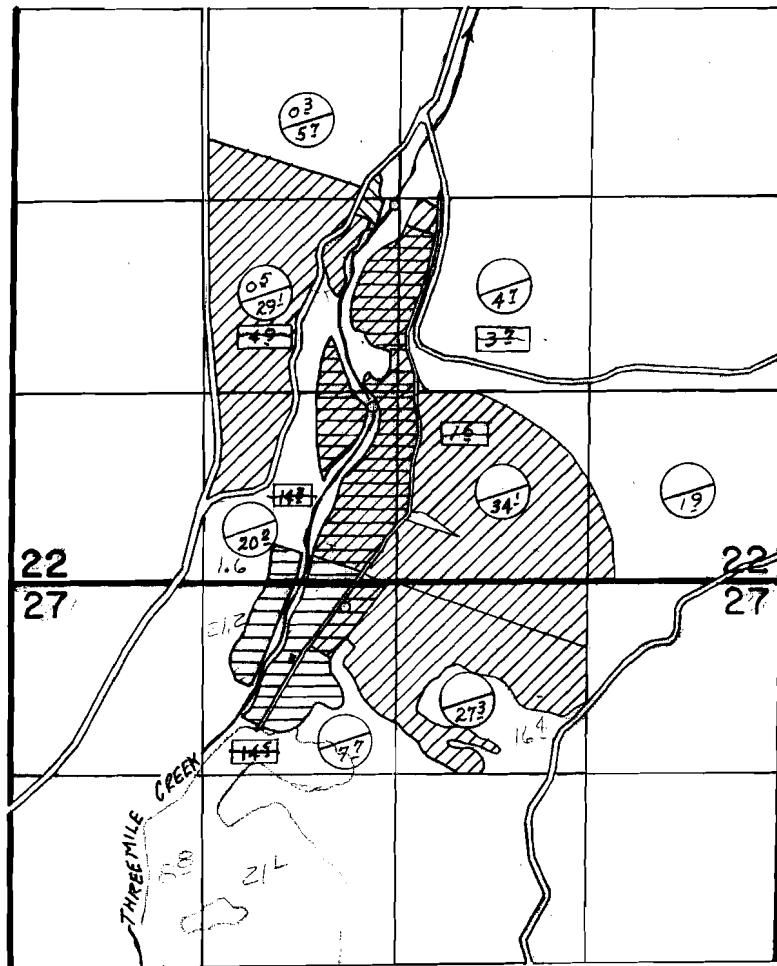

CREEK DIV. PTS. LOC. 2590' N & 1350' W ; 1200' N & 1490' W. WELL LOC. 170' S & 1660' W - ALL FROM THE SE COR. SW 1/4 SE 1/4 SEC. 22

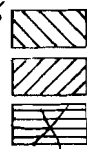

○ PRIMARY WELL  
 ○ SUPPLEMENTAL WELL  
 □ X FROST PROTECTION NOT USED

## FINAL PROOF SURVEY UNDER

G-8638                      G-8294  
 Application No. 57069    Permit No. 43517  
 IN NAME OF

C. & F. ORCHARDS

Surveyed Nov. 28, 1983, by T. J. Paul