


T.26S.,R.6W.,W.M.

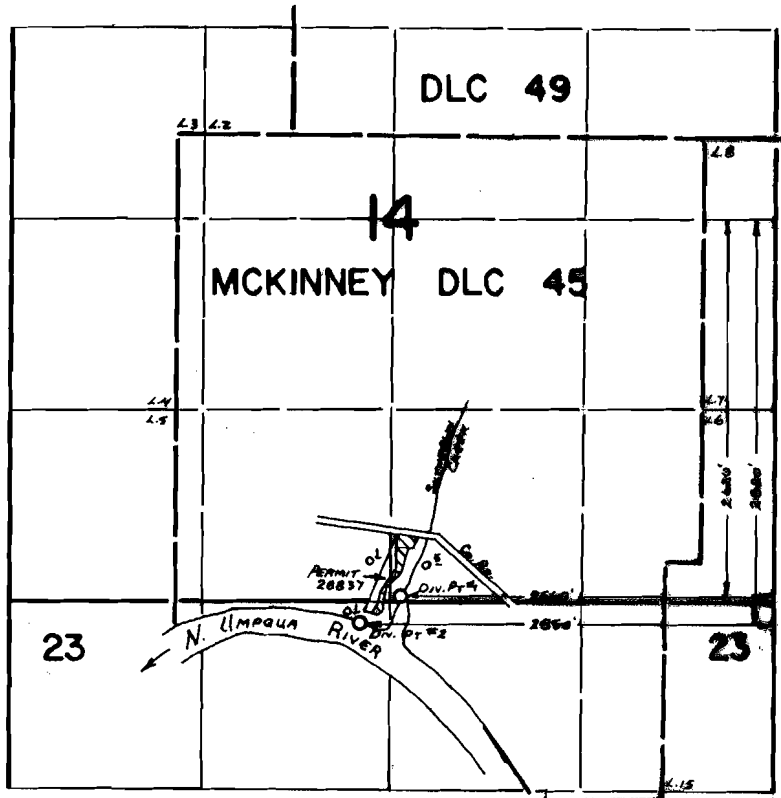

FINAL PROOF SURVEY
UNDER

Transfer No. 4168
Application No. ...5838J... Permit No. ...43986.....
IN NAME OF

MICHAEL RAY & LINDA MARIE HORN

Surveyed May...13... 19.82., by L.M.TOLL.....