


T. 15 S., R. 39 E., W. M.

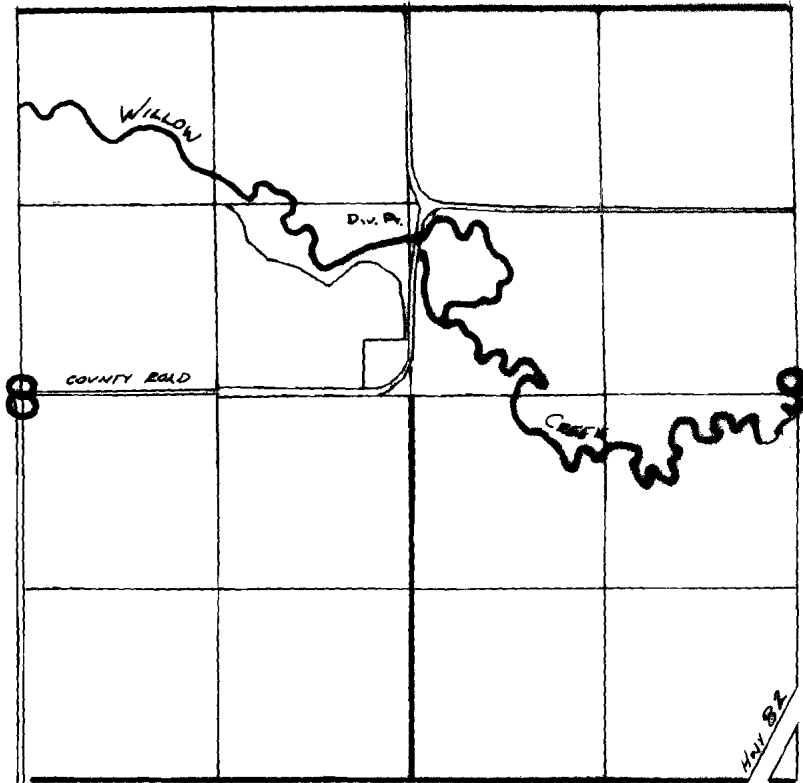

D.V. Pt. Loc: 1560'S & 30'E. FROM NW COR. SEC 9

**FINAL PROOF SURVEY**  
UNDER


**TRANSFER 4538**

IN NAME OF

.....DOYLE.....EISIMINGER.....

Surveyed Nov. 18, 1981, by P.R. Church.....

# T.I.S.R.39E.W.M.

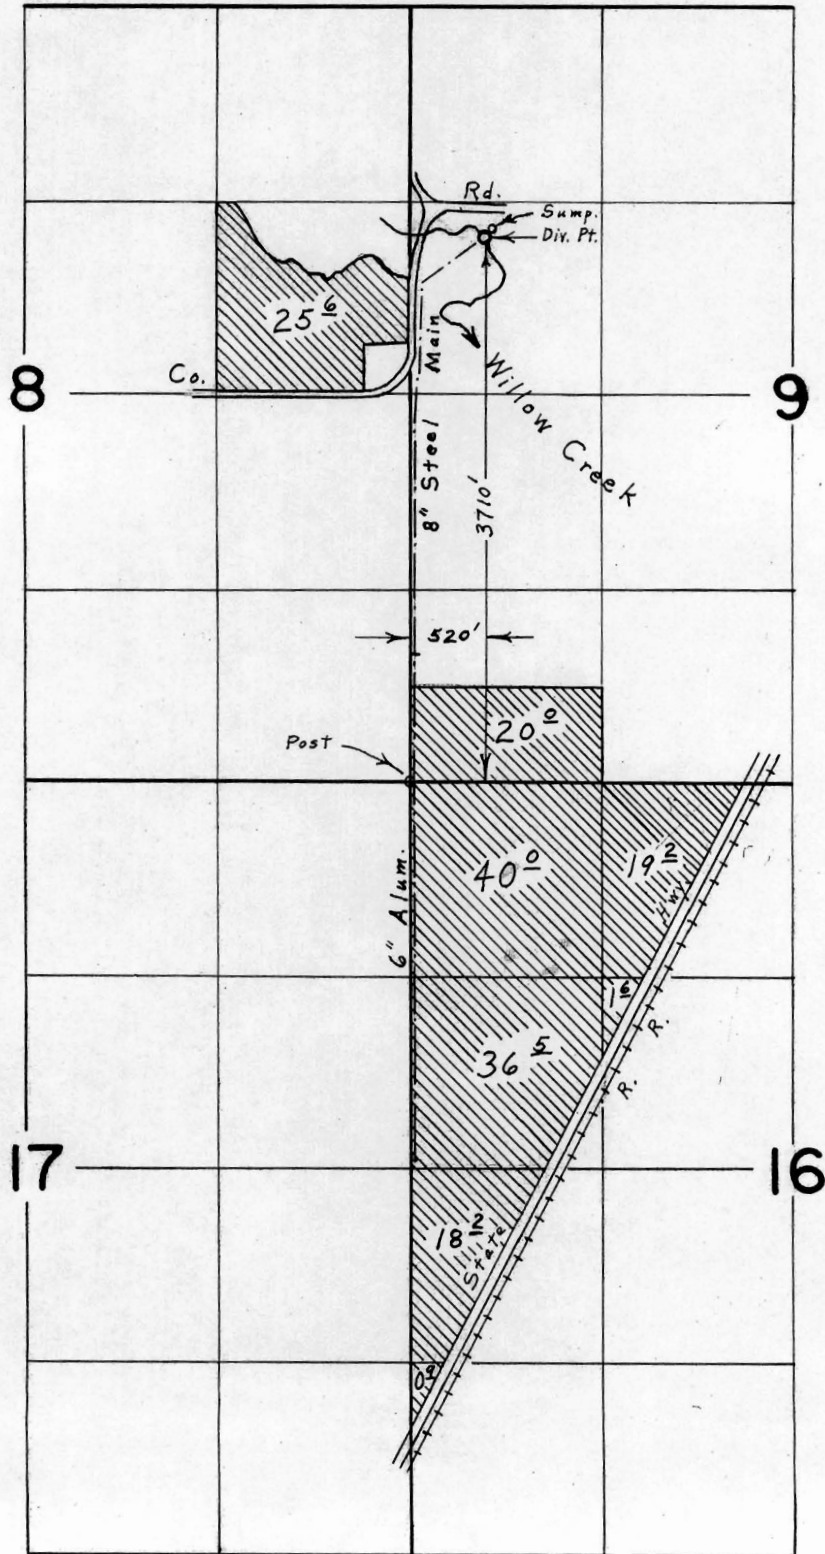

## FINAL PROOF SURVEY UNDER

Application No. 37411 Permit No. 27863  
IN NAME OF  
REED TAYLOR

Surveyed October 31, 1966 by L. E. Gould