


T. 7 S. R. 39 E. W. M.

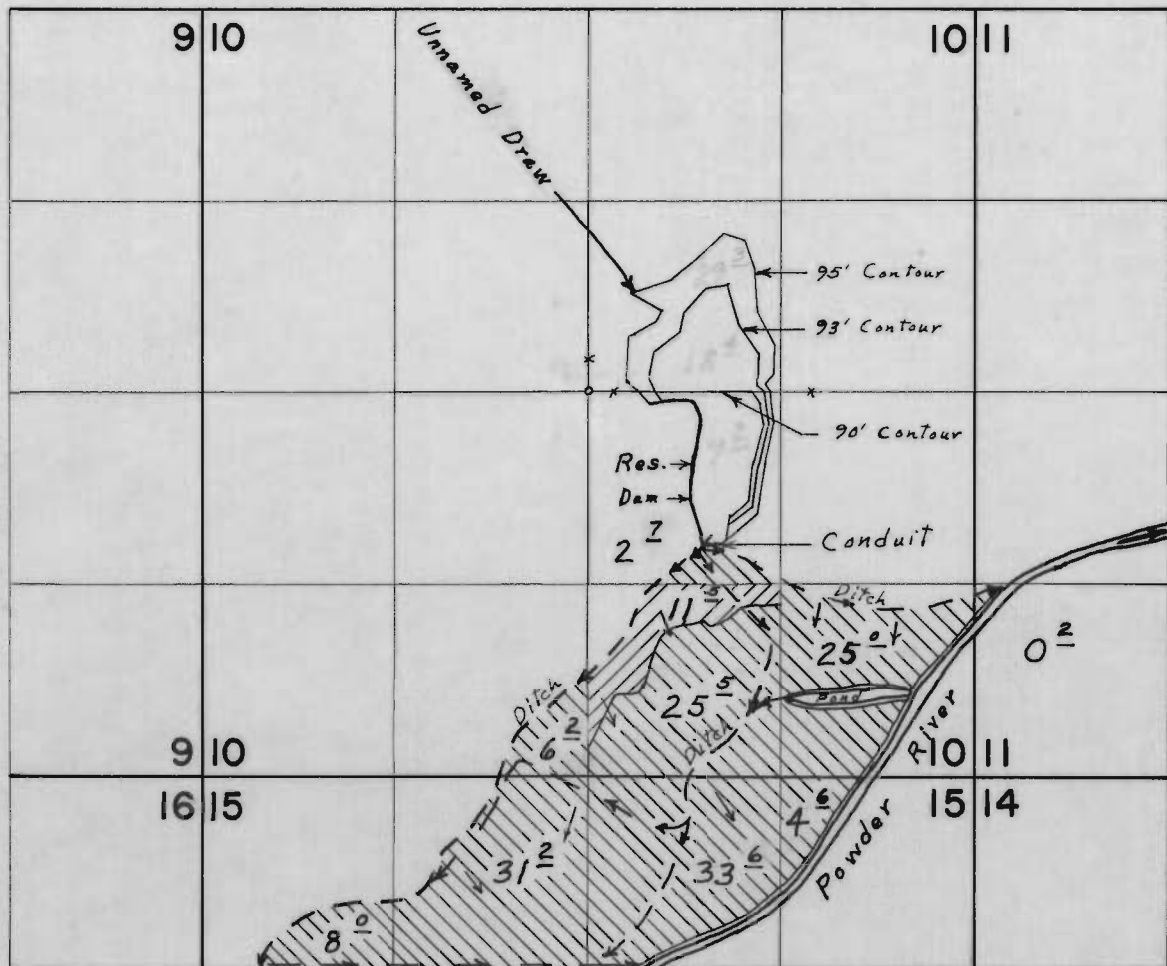

Div. Pt. located 1040' S. & 800' E. from center Section 10

FINAL PROOF SURVEY UNDER

59560 44618
 R-58190 R- 7983
 R-44814 R- 5295
 Application No. 44815 Permit No. 33518

IN NAME OF
MARION C. INMAN

Surveyed May 16, 1970, by L. E. Gould