


T. 12S. R. 58.6 W. W. M.

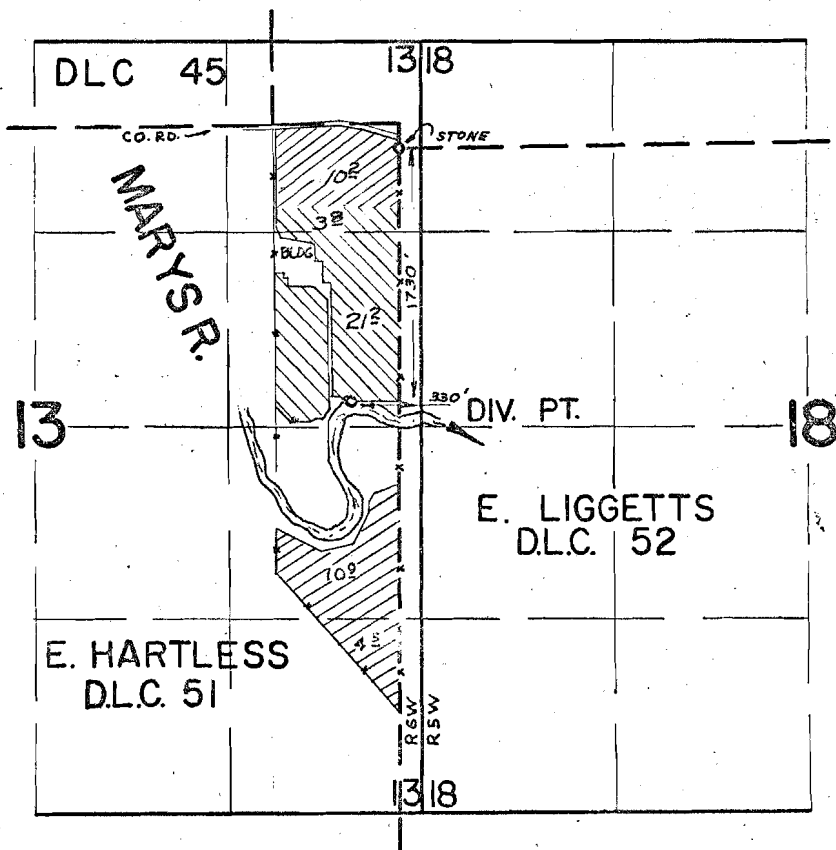

FINAL PROOF SURVEY
UNDER

Application No. 37455 Permit No. 27885 
40414 
IN NAME OF

GILBERT FAXON

Surveyed APRIL 6, 1966, by W. Harmer