

RECEIVED
 APR 23 1997
 WATER RESOURCES DEPT.
 SALEM, OREGON

Application No. *L-83869*
 Permit No. *R12232*

SEE MAP 09 2W 33B

NOTE: THIS ACREAGE ASSESSED WITH TABLE ON ON MAP 09 2W 33B

SEE MAP 09 2W 33BA

RECEIVED
 SEP 17 2003
 WATER RESOURCES DEPT.
 SALEM, OREGON

Certified Water Right Examiner
 381 WARE
 Robert D. Finkenz
 May 11, 1994
 STATE OF OREGON

9 2W 28C

High Swarver Rd
Ainsville, OR
Water
Storage Permit
Map 1/2

SEE MAP 09 2W 28

1"=200'
 26-APR-90




RECEIVED


APR 23 1997

WATER RESOURCES DEPT.
SALEM, OREGON


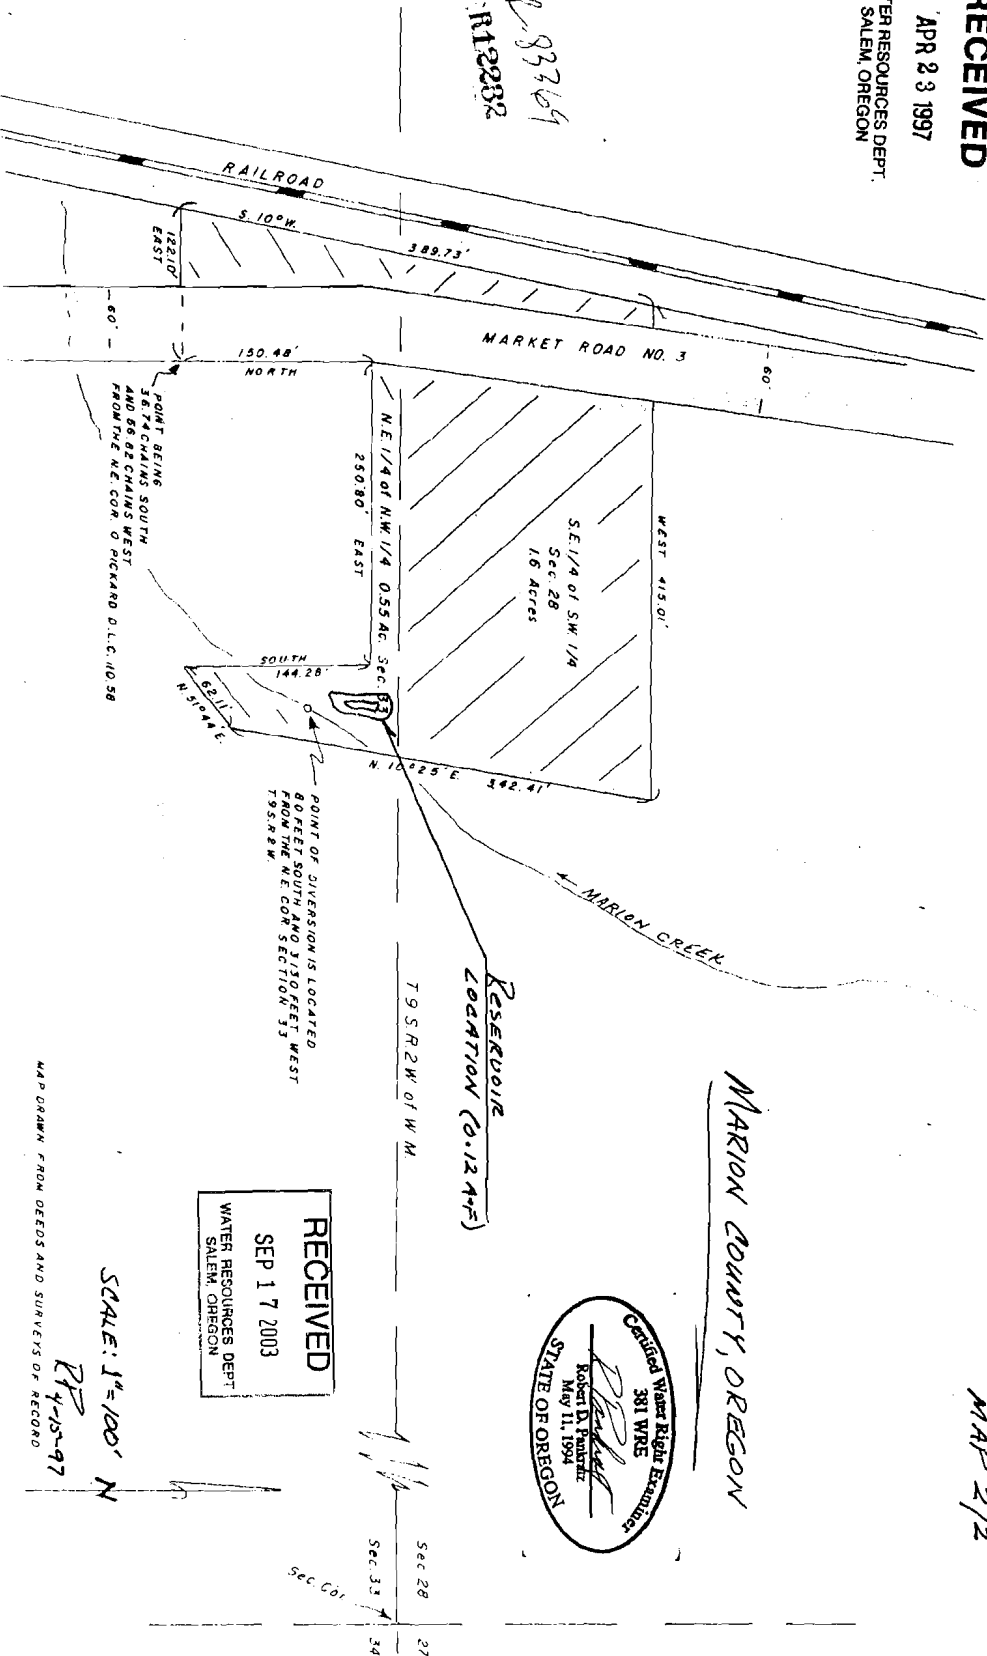

MARION COUNTY, OREGON

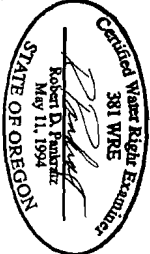

HIGH SWARTERUD

AINSWILLE, OR

WATER

STORAGE PERMIT

MAP 2/2

Reservoir
Location (0.1245)

POINT OF DIVERSION IS LOCATED
T9S, R2W.

POINT BEING
FROM THE N.E. COR. OF PICKARD D.L.C. 1058

RECEIVED
SEP 17 2003
WATER RESOURCES DEPT.
SALEM, OREGON

SCALE: 1"=100' N

MAP DRAWN FROM DEEDS AND SURVEYS OF RECORD

RJ
11-15-97