


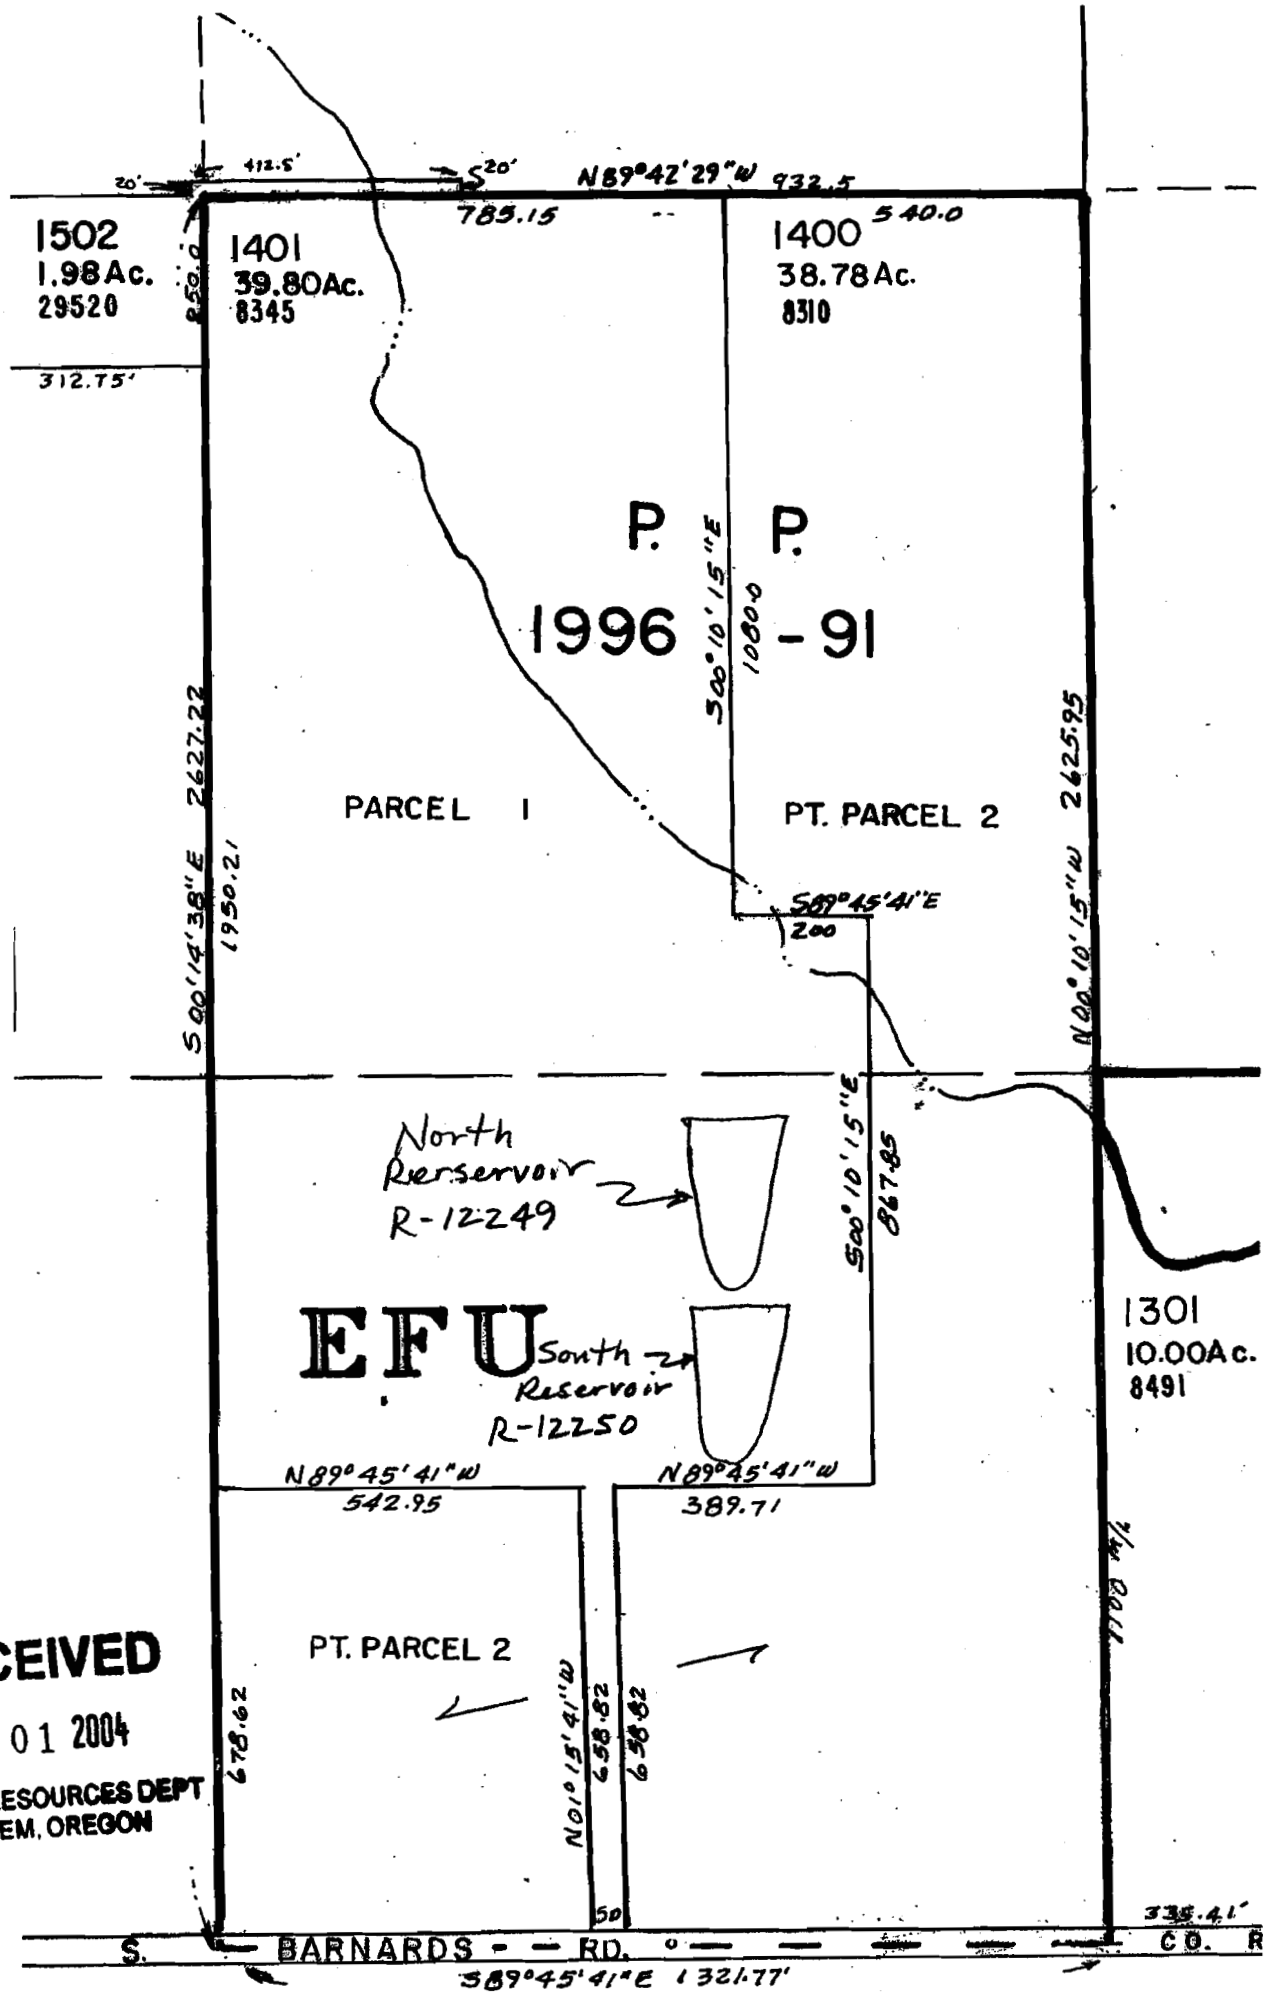

RECEIVED

NOV 01 2004

WATER RESOURCES DEPT
SALEM, OREGON