




SCALE
1" = 400'

365-6w-33

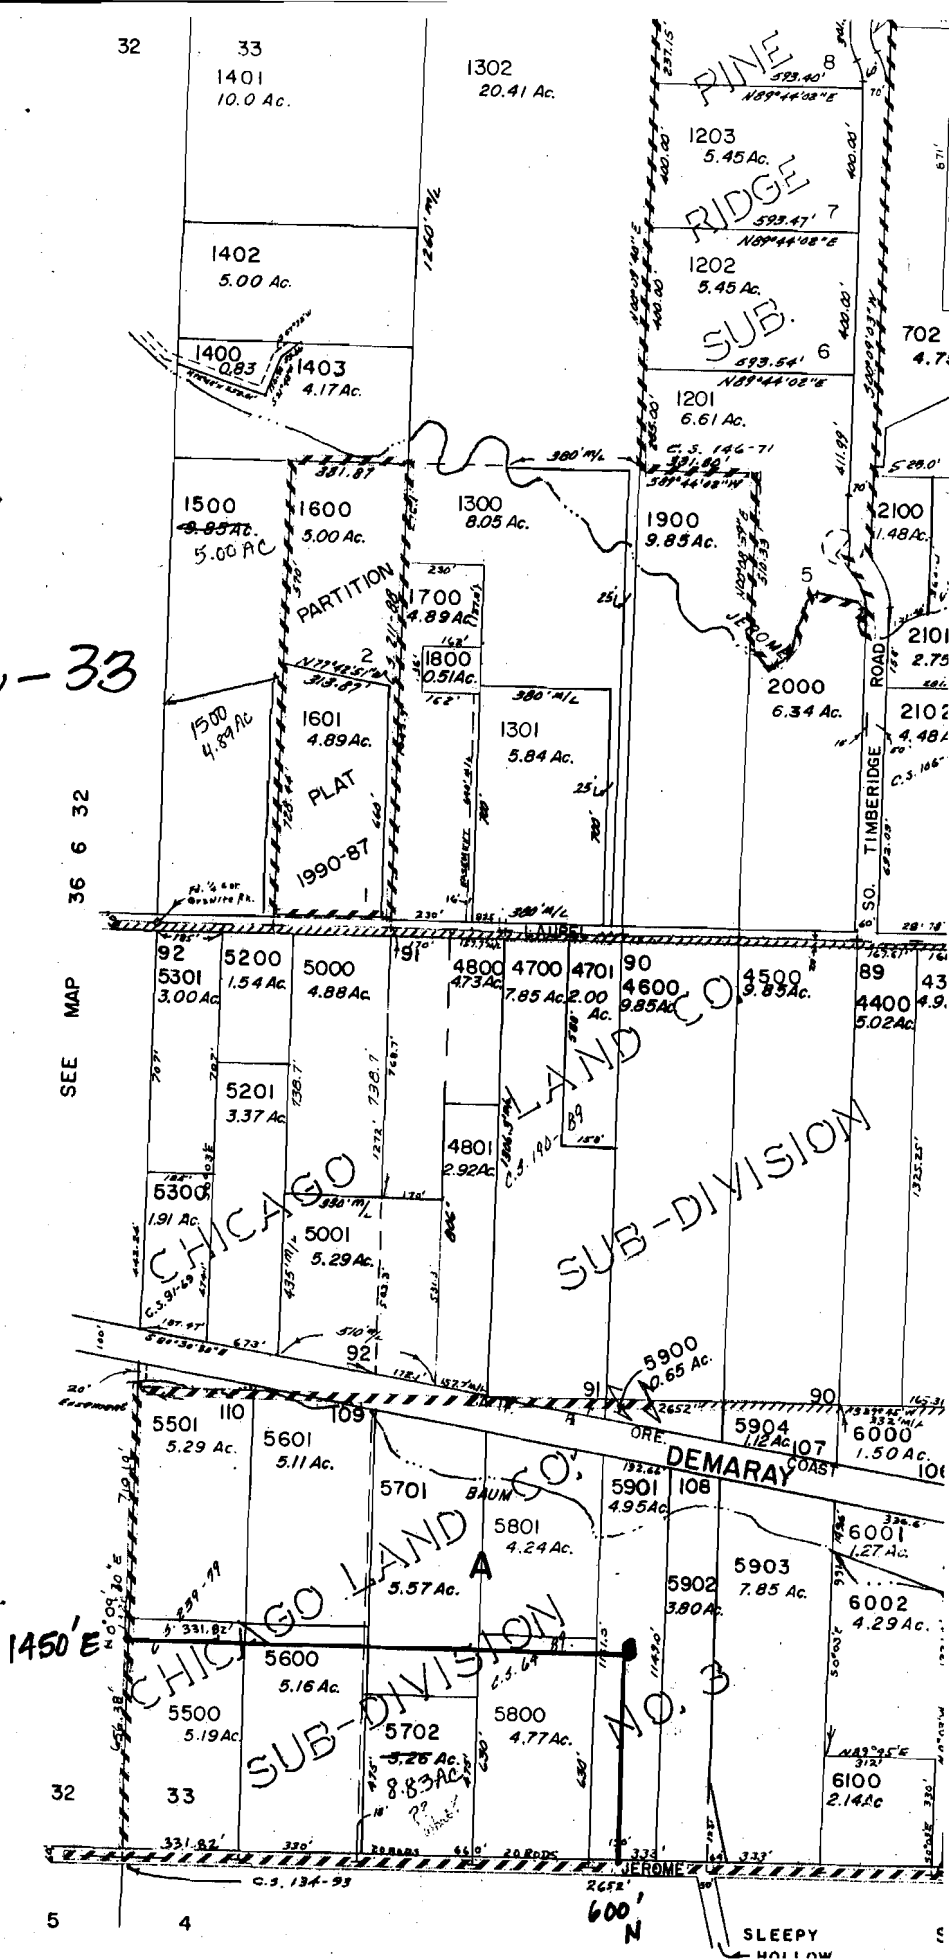

SEE MAP 36 6 32

1450' E

SLEEPY HOLLOW