


T.27S., R.5W., SEC 10
SCALE: 1"=400' SEE MAP 27 5 3

RECEIVED
NOV 16 2004
WATER RESOURCES DEPT
SALEM, OREGON

Application No. R-84110, R-84109, R-84108
Permit No. R-12728, R-12727, R-12726

12-00

RECEIVED
APR 8 1999
WATER RESOURCES DEPT.
SALEM, OREGON

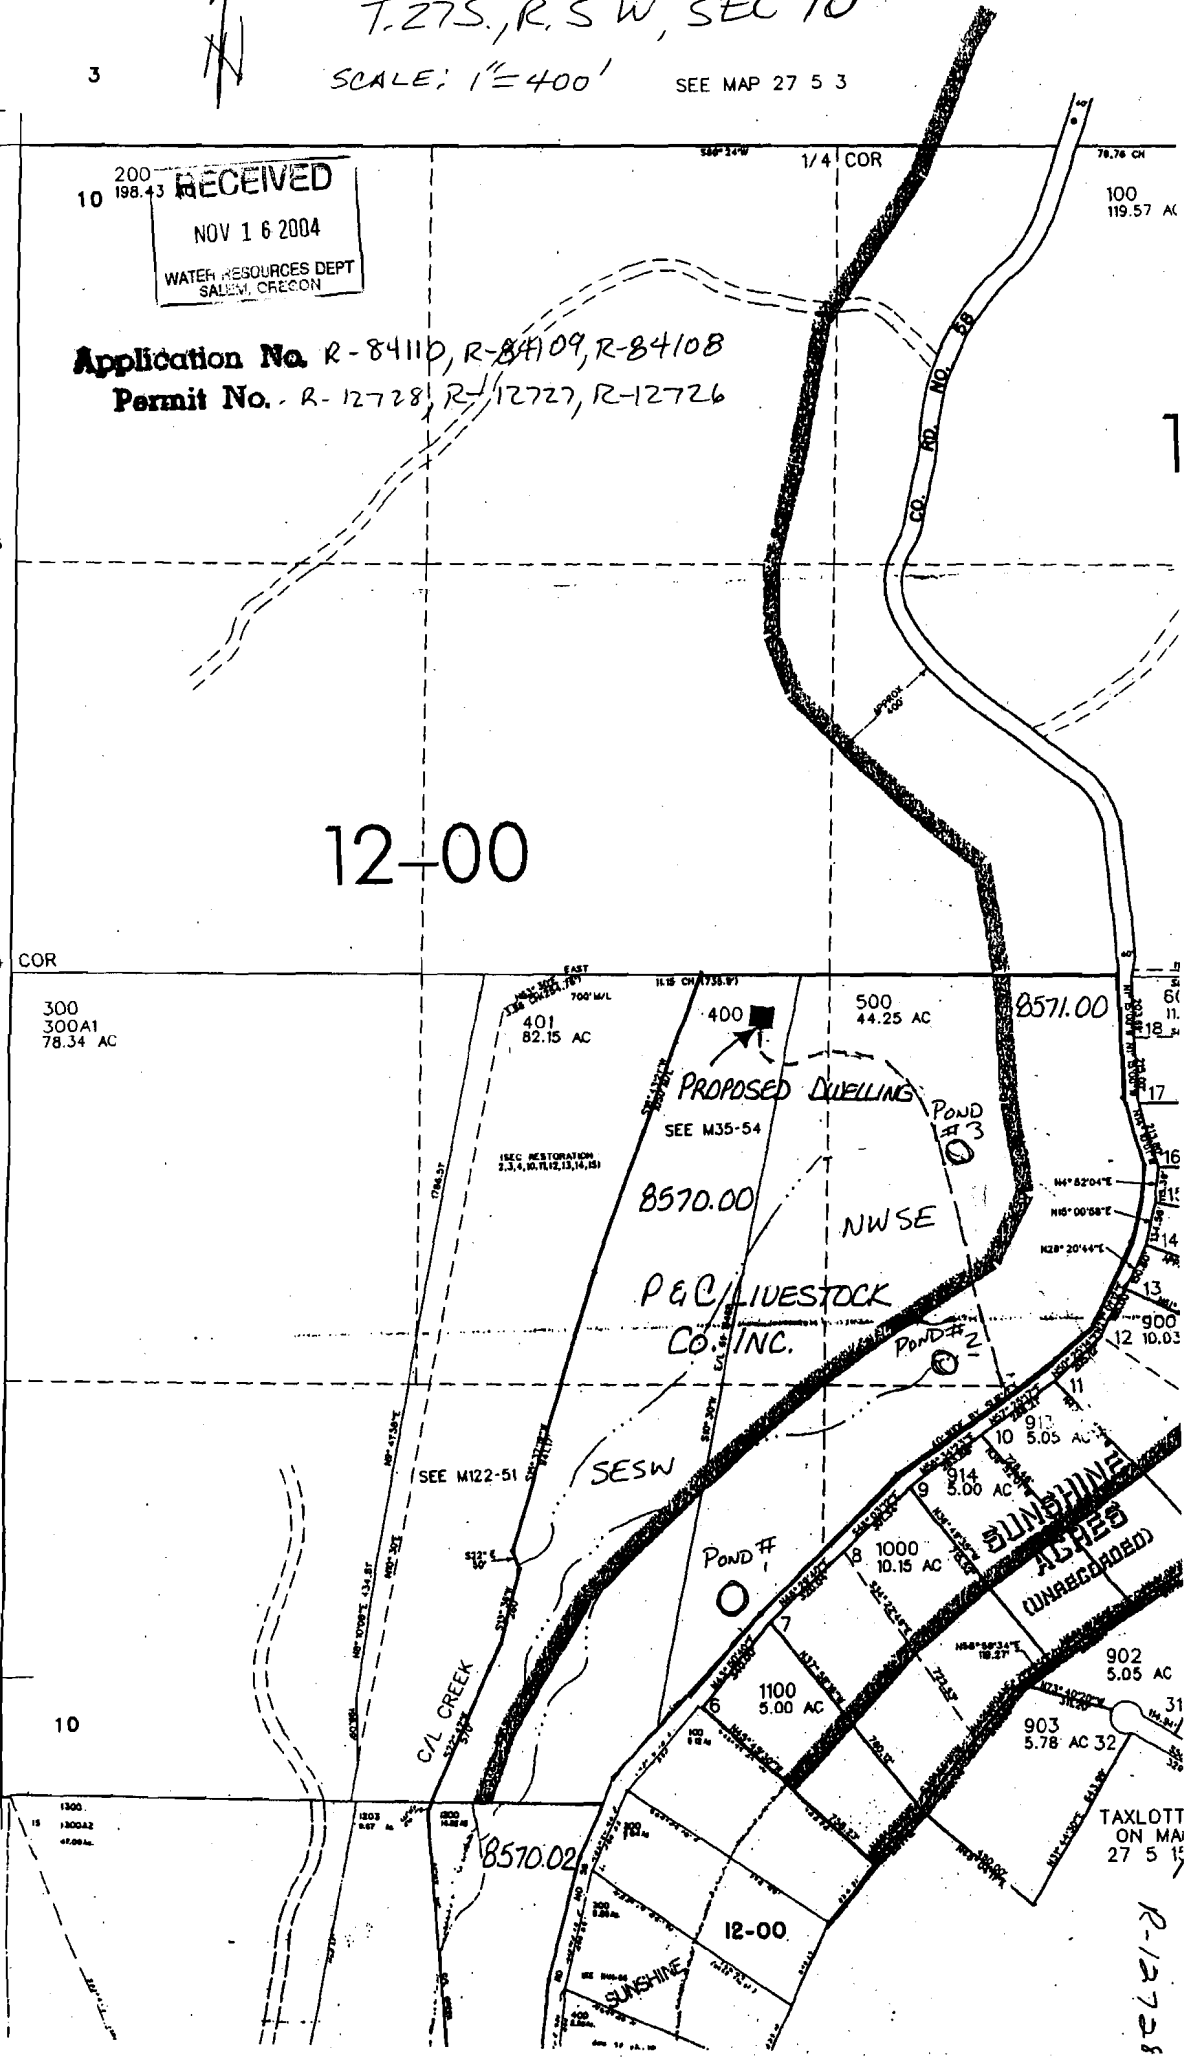

TAXLOTT
ON MAY
27 5 15

R-12728