RECEIVED
SEP 15 2008
WATER RESOURCES DEPT
SALEM, OREGON

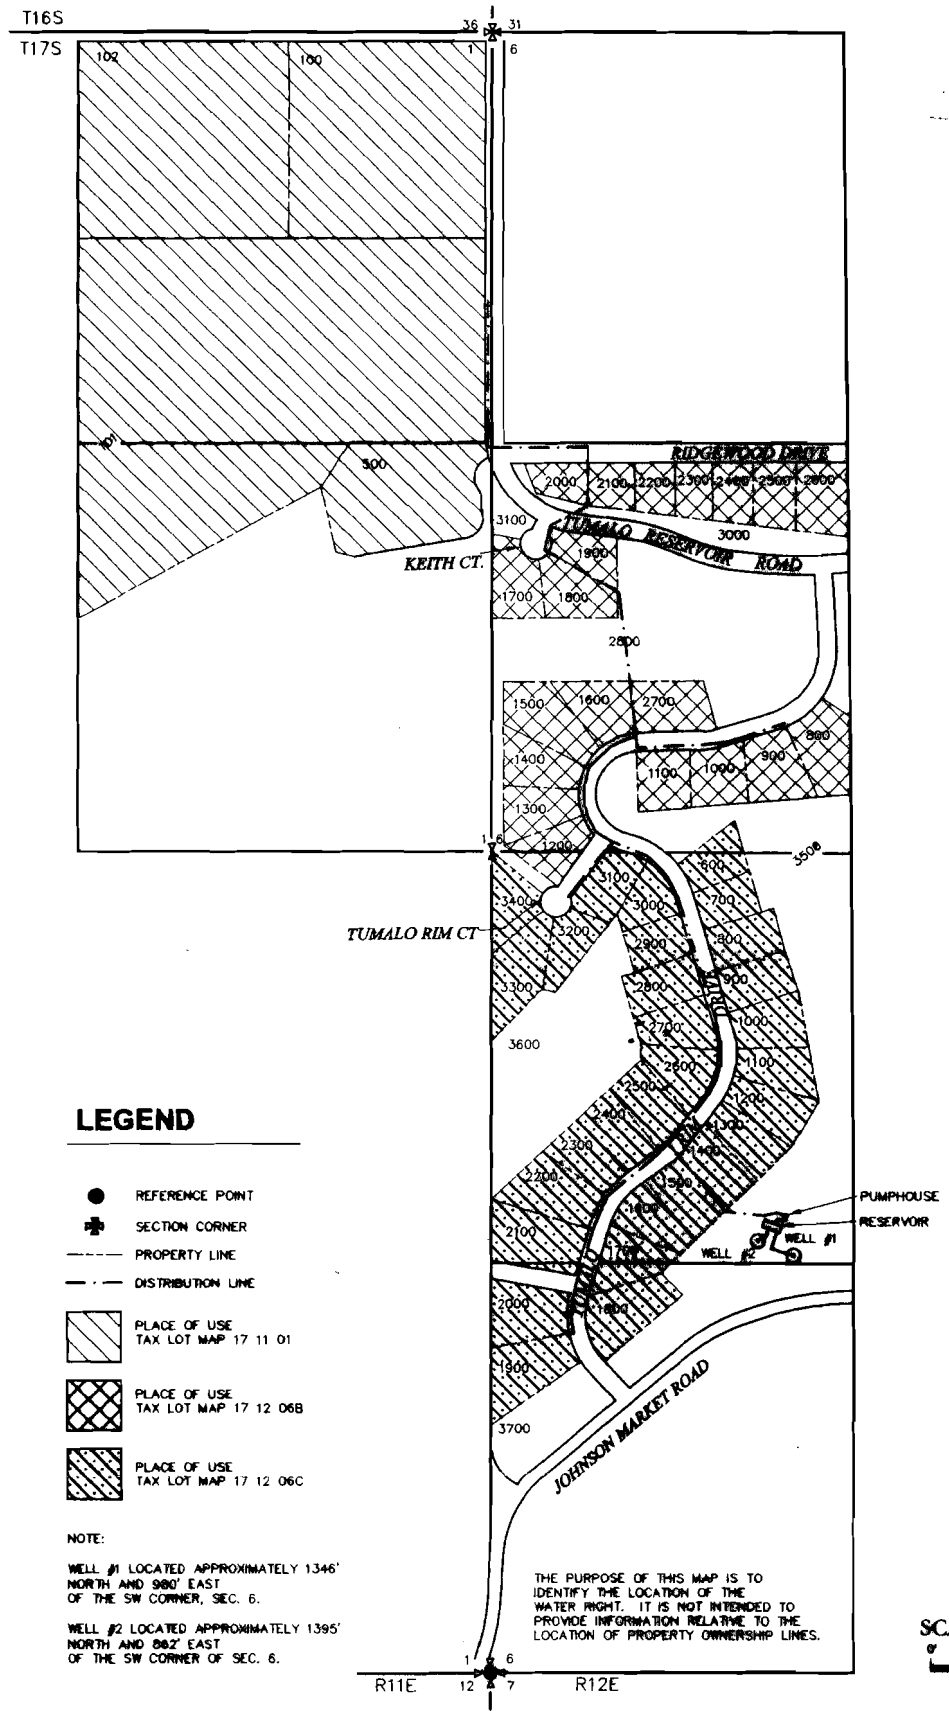

LEGEND

- REFERENCE POINT
- SECTION CORNER
- PROPERTY LINE
- DISTRIBUTION LINE
- PLACE OF USE TAX LOT MAP 17 11 01
- PLACE OF USE TAX LOT MAP 17 12 06B
- PLACE OF USE TAX LOT MAP 17 12 06C

NOTE:

WELL #1 LOCATED APPROXIMATELY 1346' NORTH AND 980' EAST OF THE SW CORNER, SEC. 6.

WELL #2 LOCATED APPROXIMATELY 1395' NORTH AND 882' EAST OF THE SW CORNER OF SEC. 6.

THE PURPOSE OF THIS MAP IS TO IDENTIFY THE LOCATION OF THE WATER RIGHT. IT IS NOT INTENDED TO PROVIDE INFORMATION RELATIVE TO THE LOCATION OF PROPERTY OWNERSHIP LINES.

SCALE: 1"=400'

CORU MAP # 0174

Project #: 00096.000
Date: SEPT 1995

Certified Water Right Examiner
445WRE
Terry Ann Sprecher
06/13/97
STATE OF OREGON

REVISED CLAIM OF BENEFICIAL USE MAP

APPLICATION #G-13726 PERMIT #G-13136

TUMALO RIM WATER IMPROVEMENT DISTRICT

BEND, OREGON

PBS