

SECTION 27, T.2 N., R.4 W., W.M.

WASHINGTON COUNTY, OREGON

RECEIVED

FEB 13 2004

WATER RESOURCES DEPT
SALEM, OREGON

2390'

T.L. 402

SCALE: 1"=400'

MAP BASE:
ASSESSORS MAP
ASSESSORS PHOTO
CONSTRUCTION DRAWINGS

SPRING


RESERVOIR "D"

PERMIT
R-11800

POND #2

BARN


POND #1

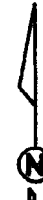

DAVID A. and JUDITH R.
MADSEN

14405 N.W. KILLEN ROAD
P.O. BOX 219
BANKS, OR 97108

designed	by	DATE
drawn	by	DATE
checked	by	DATE
drawing no.		Sheet no.
		1/1

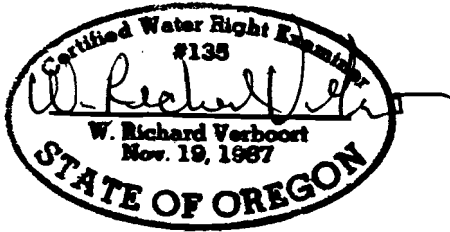

FINAL PROOF SURVEY

UNDER

APPLICATION

PERMIT

R-84355

R-12914

SURVEYED DECEMBER 17, 2003

1750'

N.W. KILLEN ROAD

PREPARATION OF THIS MAP IS FOR THE
PURPOSE OF IDENTIFYING THE LOCATION OF
THE WATER RIGHT ONLY. THERE IS NO INTENT
TO PROVIDE DIMENSIONS OR LOCATION OF
PROPERTY OWNERSHIP LINES.

28 27

33 34

N.W. NARUP ROAD

VERBOORT ENGINEERING

AGRICULTURE · CIVIL · WATER RESOURCES
MILLSBORO, OREGON