

RECEIVED
AUG 31 2001
WATER RESOURCES DEPT
SALEM, OREGON


COLUMBIA EMPIRE FARMS, INC
R-2 RANCH POND # 3

T. 9 S., R. 16 E., W.M.

SECTION 32

N

SCALE: 1" = 2000'

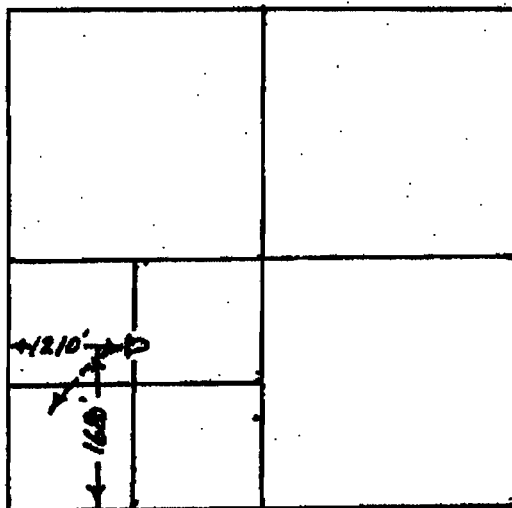

Application No. R 84891
Permit No. R-13263

RECEIVED

AUG 12 2003

WATER RESOURCES DEPT.
SALEM, OREGON