


COLUMBIA EMPIRE FARMS, INC
R-2 RANCH POND # 9

T. 9 S., R. 15 E., W. M.

SECTION 21

N
SCALE: 1" = 2000'

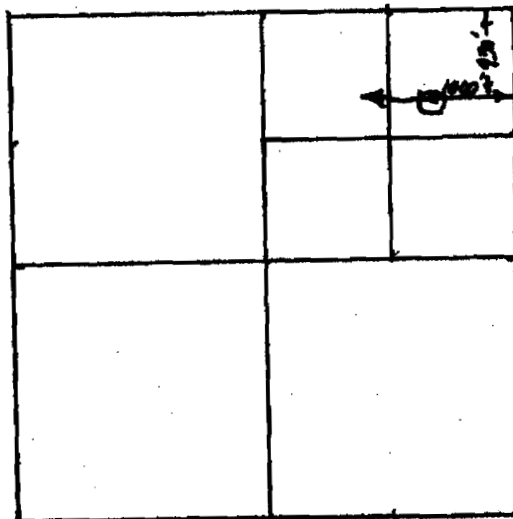

Application No. R-4895
Permit No. R-13267

