
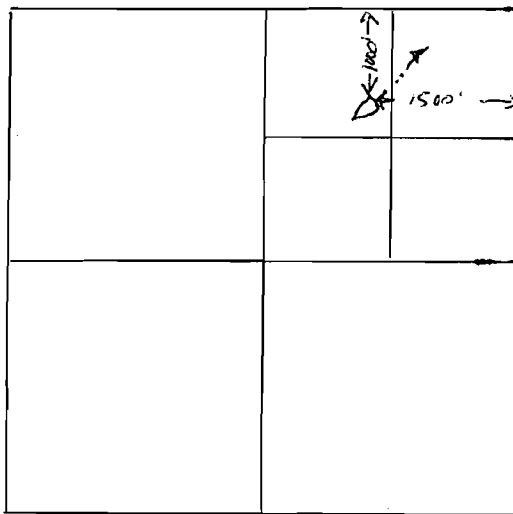


RECEIVED  
AUG 31 2001  
WATER RESOURCES DEPT  
SALEM, OREGON

COLUMBIA EMPIRE FARMS, INC  
R-2 RANCH POND # 23

T. 6 S., R. 15 E., W. M.

SECTION 19

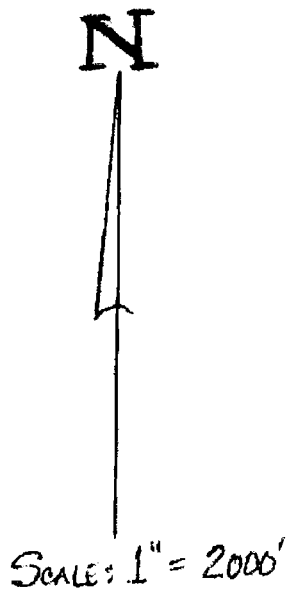

Application No. R84905  
Permit No. R-13298