
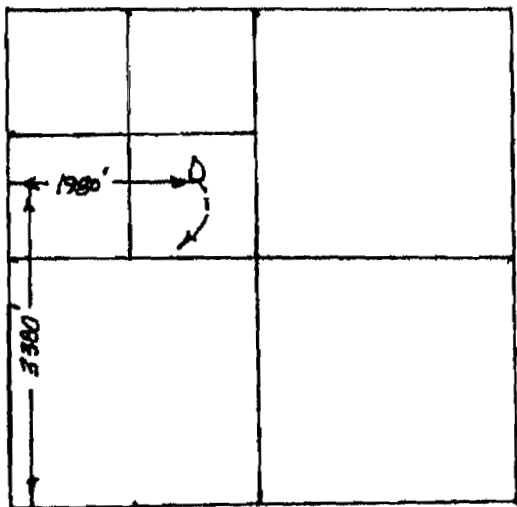


RECEIVED
AUG 31 2001
WATER RESOURCES DEPT
SALEM, OREGON

COLUMBIA EMPIRE FARMS, INC
R-2 RANCH POND # 20

T. 8 S., R. 14 E., W.M.
SECTION 36

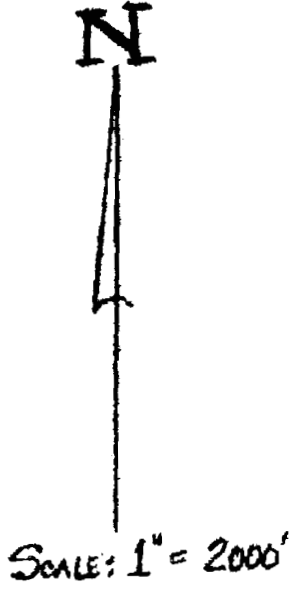

Application No. R84902
Permit No. R-13273

RECEIVED
AUG 12 2003
WATER RESOURCES DEPT.
SALEM, OREGON