
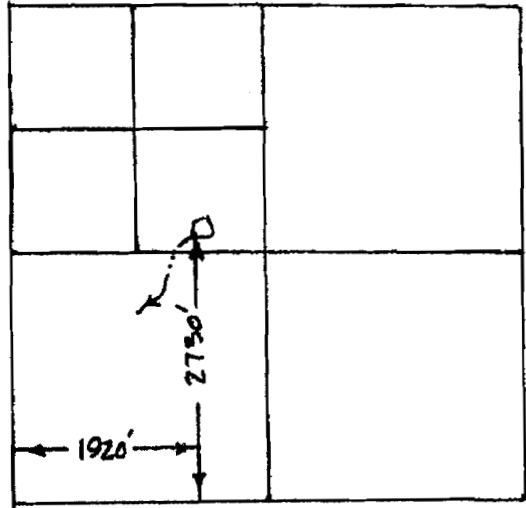


RECEIVED
AUG 3 1 2003
WATER RESOURCES DEPT.
SALEM, OREGON

COLUMBIA EMPIRE FARMS, INC
R-2 RANCH POND # 19
T. 8 S., R. 14 E., W.M.
SECTION 36

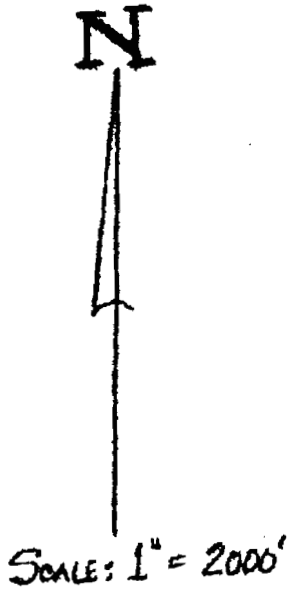

Application No. R-84901
Permit No. R-13272

RECEIVED
AUG 1 2 2003
WATER RESOURCES DEPT.
SALEM, OREGON