

RECEIVED
AUG 31 2003
WATER RESOURCES
SALEM, OREGON


COLUMBIA EMPIRE FARMS, INC
R-2 RANCH POND # 16

T. 8 S., R. 15 E., W.M.
SECTION 16

N



Scale: 1" = 2000'

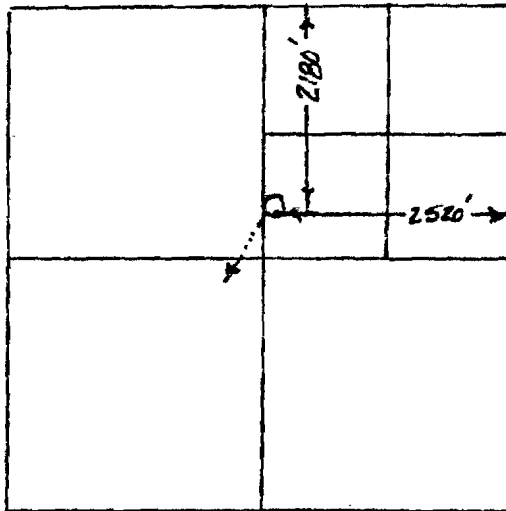

Application No. RP4899
Permit No. R-13270

RECEIVED

AUG 12 2003

WATER RESOURCES DEPT.
SALEM, OREGON