


RECEIVED
AUG 3 1 2001
WATER RESOURCES DEPT
SALEM, OREGON

R-2 RANCH POND #1
COLUMBIA EMPIRE FARMS
T. 9S., R. 15E., W.M.
SECTION 14

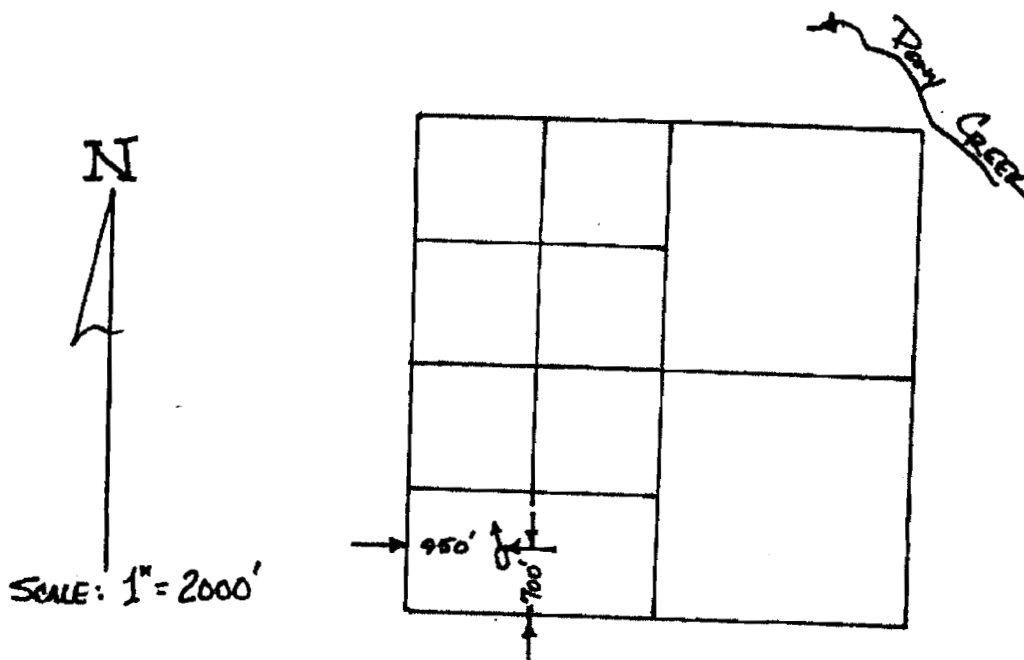

Application No R84896
Permit No. R-13268

RECEIVED
AUG 1 2 2003
WATER RESOURCES DEPT.
SALEM, OREGON