

COLUMBIA EMPIRE FARMS, INC
R-2 RANCH POND # 27


T. 7 S., R. 15 E., W.M.

SECTION 4

N



SCALE: 1" = 2000'

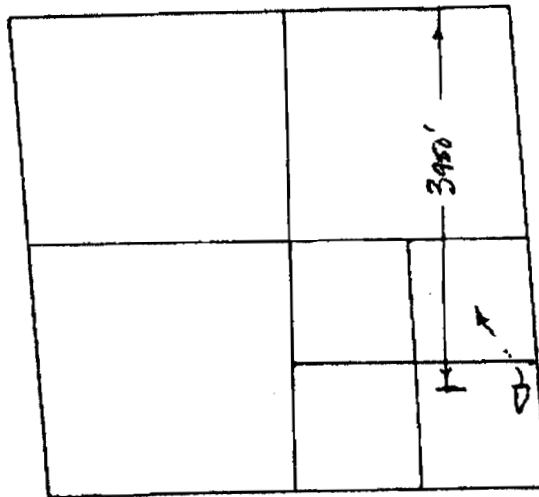

RECEIVED

AUG 12 2003

WATER RESOURCES DEPT.
SALEM, OREGON