


COLUMBIA EMPIRE FARMS, INC
R-2 RANCH POND # 34

T. 6 S., R. 15 E., W. M.
SECTION 16

N



SCALE: 1" = 2000'

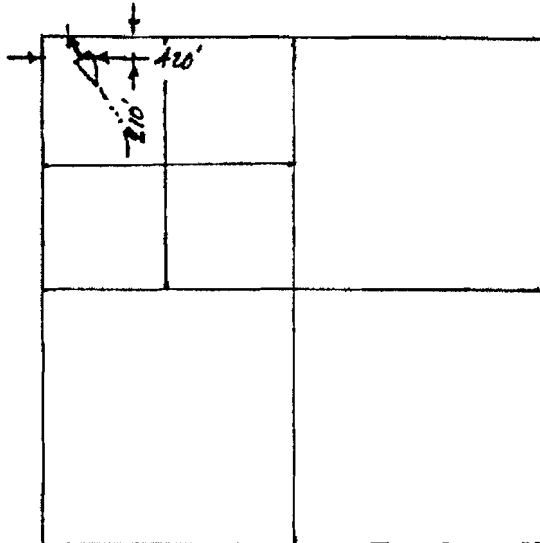

RECEIVED

AUG 12 2003

WATER RESOURCES DEPT.
SALEM, OREGON