


T.28S.,R.16E.W.M.

REVISED

2<sup>nd</sup> 1997

DEPT. OF REVENUE  
1997

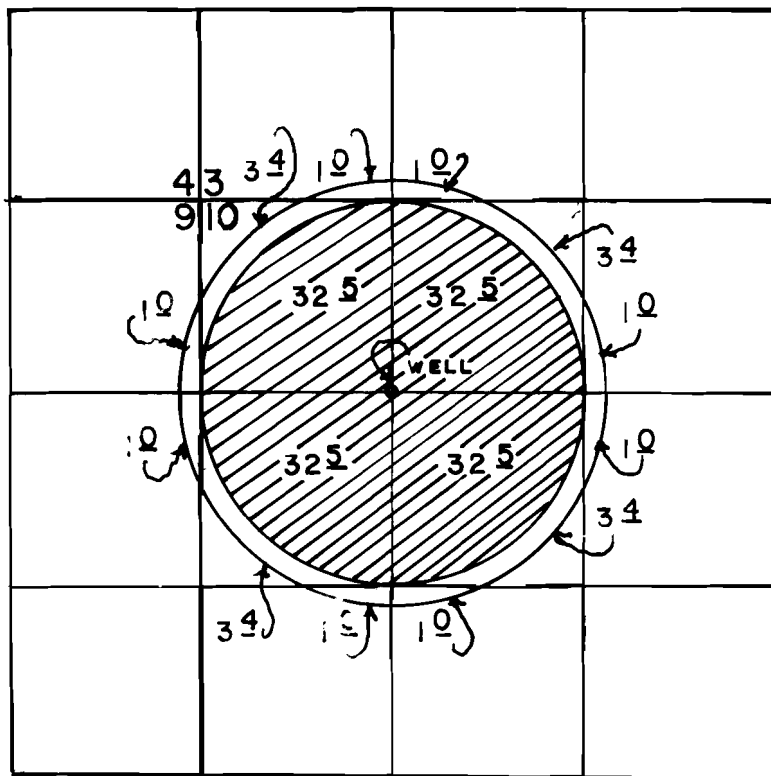

WELL LOC: 1320' S & 1320' E FROM NW COR. OF SEC. 10.

SCALE: 1" = 1320'

**FINAL PROOF SURVEY**  
UNDER

Application No. G-11200 Permit No. G-10701...  
IN NAME OF

..... DAVID AXON .....

Surveyed APRIL 14 1997, by R.M. SUTTERFIELD