


RECEIVED

DEC 19 2002

WATER RESOURCES DEPT.
SALEM, OREGON

T.35. R.1E. SECTION 25 W.M.

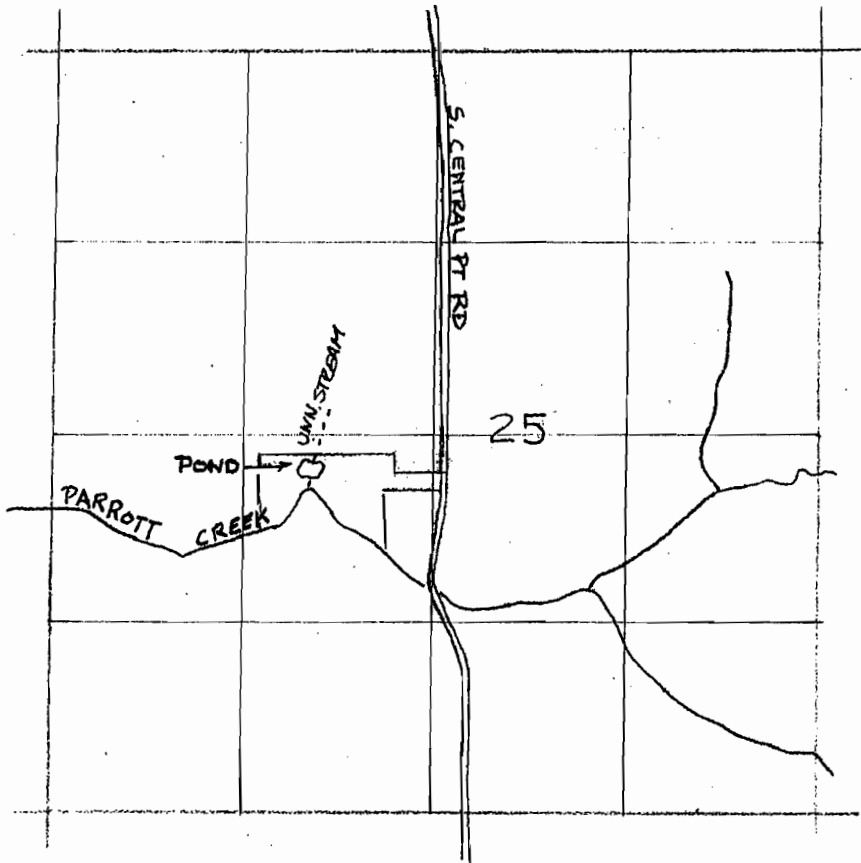

POND LOCATION:
 300 FT SOUTH AND
 1800 FT EAST FROM
 THE W 1/4 CORNER



SCALE 1:12000
 1" = 1320'
 1" = ~~1320~~ ft.

POND DMS: 045° 16' 50.8" N,
 122° 37' 55.8" W

App # R-85386
 Permit # R-13558

app # R-85386
 Permit #

RECEIVED

JAN 05 2004

WATER RESOURCES DEPT.
SALEM OREGON