


RECEIVED

EMERGENCY OVERFLOW
JAN 25 2006

WATER RESOURCES DEPT
SALEM, OREGON

SCALE 1" = 200'

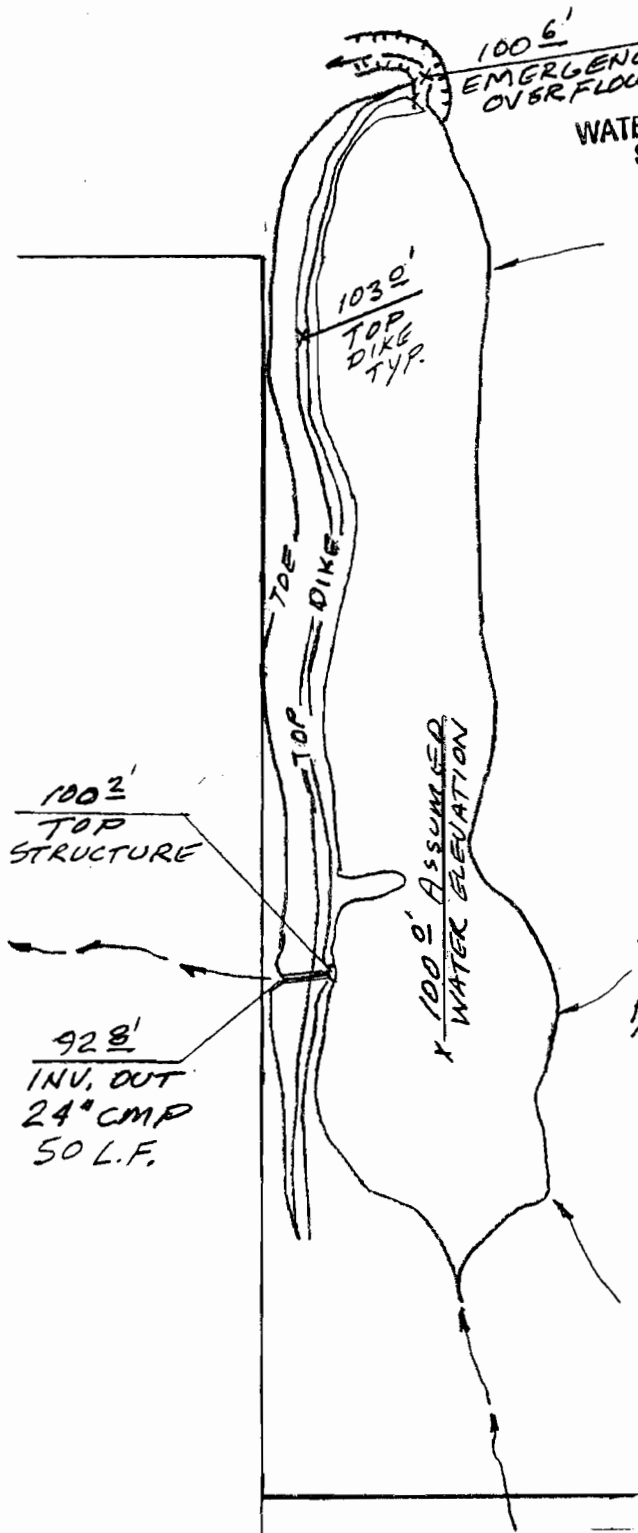

OUTLET STRUCTURE LOCATION
FROM S.W. COR DLC #43:
NORTH 2915', EAST 75'

G.P.S. NAD 83 COORD'S:
LAT. 44° 59' 31.7" N.
LONG 123° 15' 24.3" W.

SURFACE AREA (SA)
196,400 S.F. = 4.51 ACRES

VOLUME COMPUTATION:
 $V = SA \times DEPTH \times C(O.A)$
 $V = 4.51 \times 4.5' \times 0.4$
 $V = 8.12 \text{ ACRE FEET}$

CLAIM OF BENEFICIAL USE
PERMIT R-12981
LOCATED WITHIN: TAX LOT 200
H. MYERS D.L.C. # 43
(C 1/2 of the E 1/4 of SECTION 2)
T. 7N., R. 5W., W. M.
POLK COUNTY, OREGON
1/10/06 DWN: CW

BASKETT
SLOUGH
GAME REFUGE
S.W. COR
DLC #43