


23.28e

2475' s & 400' w from ne cor, sec 17

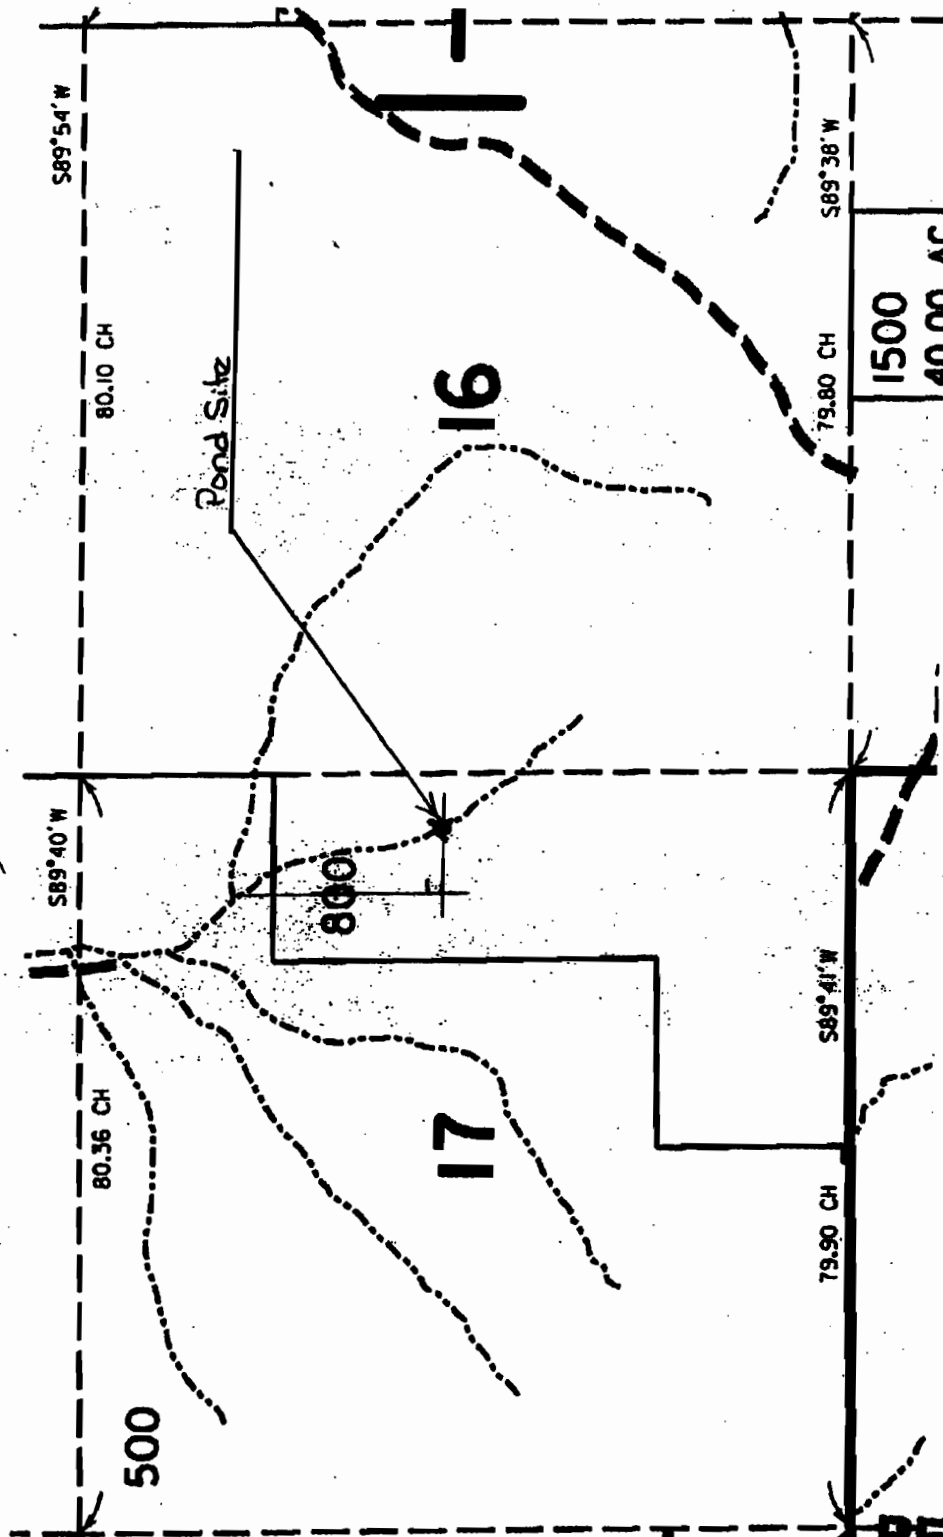

App. NO. R-85853
Permit NO. R-13949

RECEIVED

APR 14 2004

WATER RESOURCES DEPT
SALEM, OREGON