


(ALTERNATE RESERVOIR PERMIT PROCESS)
 IN NAME OF
BIG VALLEY WOODS WATER CORPORATION
 LOCATED IN SECTIONS 20 + 21, T. 2 S.,
 R. 4 E., W.M., CLACKAMAS COUNTY, OREGON
 SEPTEMBER 22, 2005

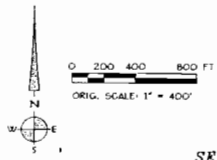


NOTES:
 1) EXISTING PONDS ARE FED BY NATURAL RUNOFF AND SPRINGS.

SITE ADDRESS:
 32700 SE LEEWOOD LANE
 BORING, OR 97009

Qualified Water Right Examiner
 #209 WRD
Paul H. Buswell
 STATE OF OREGON

RENEWAL DATE 12/31/05

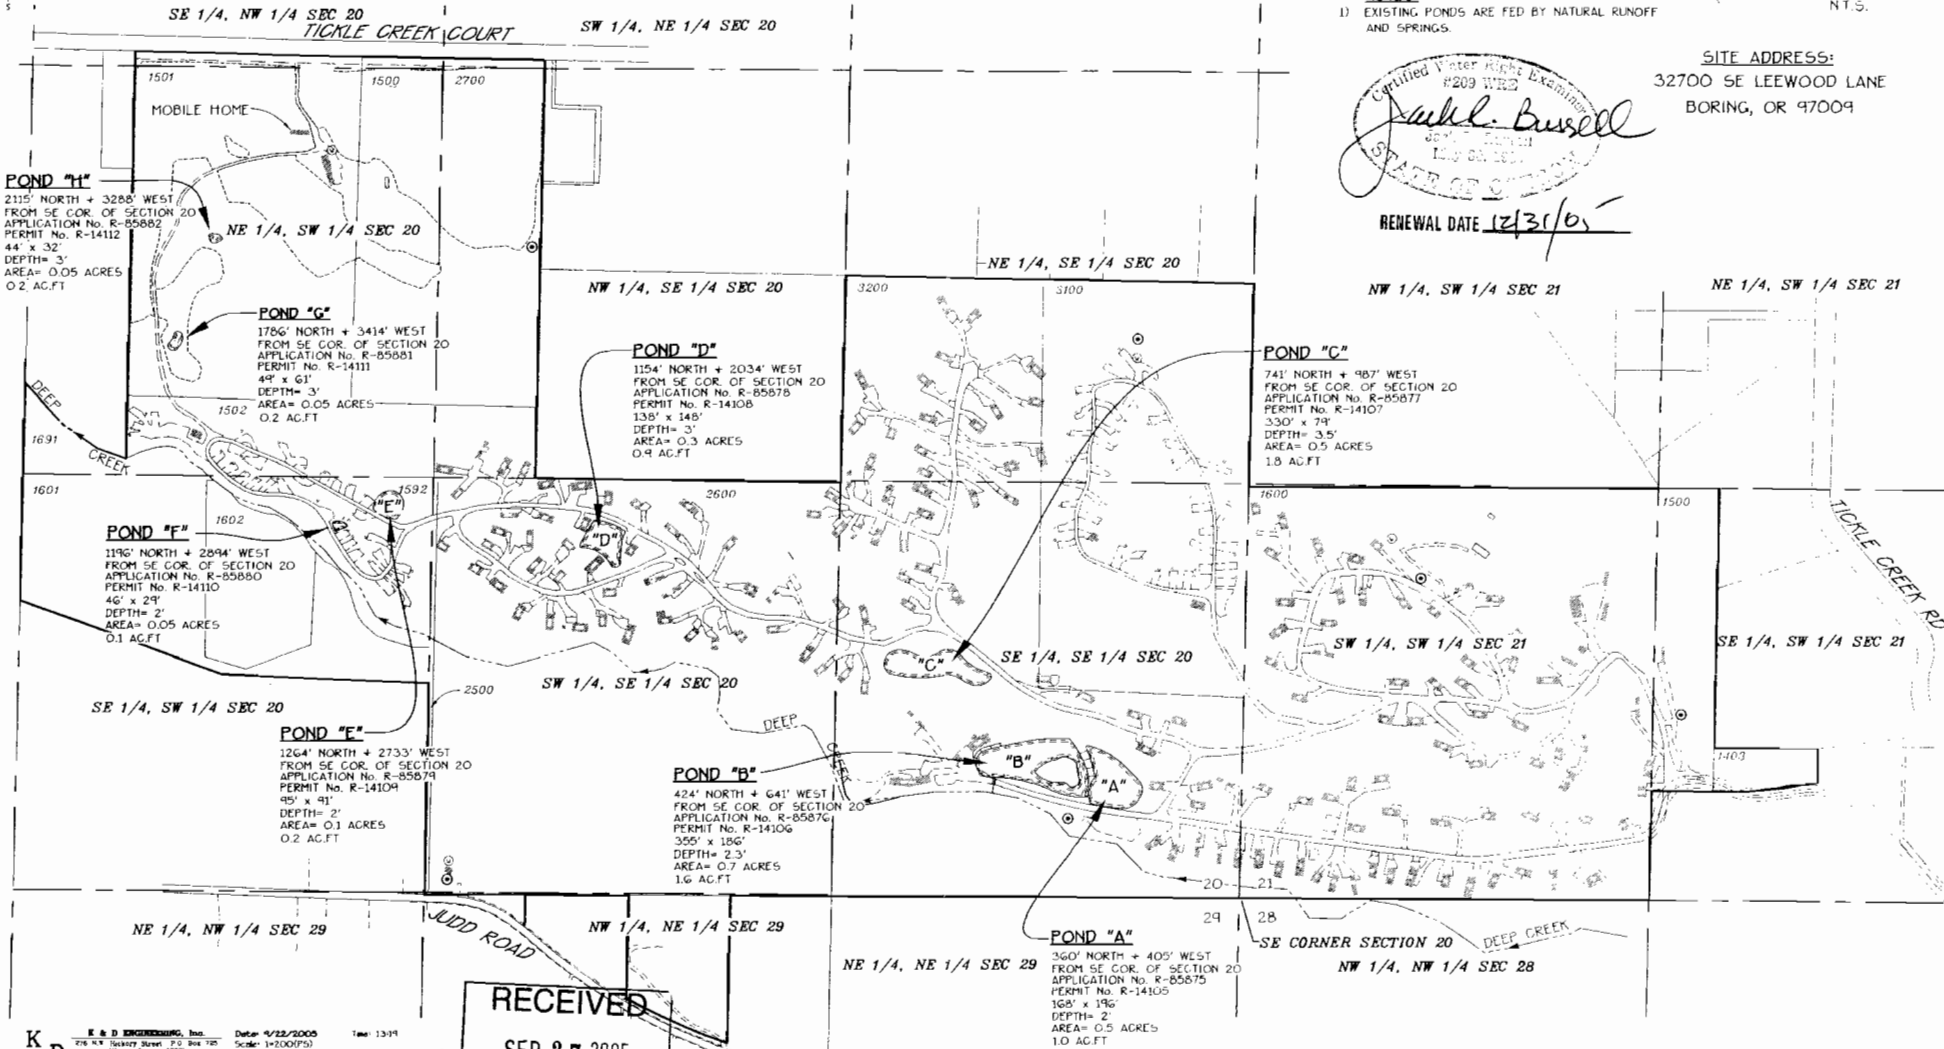

K D
 276 N. Hickory Street, P.O. Box 125
 Albany, Oregon 97141
 (541) 888-2583
 Date: 9/22/2005 Time: 13:19
 Scale: 1"=2000'(S)
 File: dwp2002\02-118\118d-wr4.dwg (Draw P)

RECEIVED
 SEP 27 2005
 WATER RESOURCES DEPT
 SALEM, OREGON