



(ALTERNATE RESERVOIR PERMIT PROCESS)
 IN NAME OF
BIG VALLEY WOODS WATER CORPORATION
 LOCATED IN SECTIONS 20 + 21, T. 2 S.,
 R. 4 E., W.M., CLACKAMAS COUNTY, OREGON
 SEPTEMBER 22, 2005

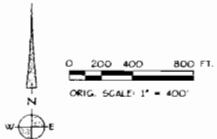

NOTES:
 1) EXISTING PONDS ARE FED BY NATURAL RUNOFF AND SPRINGS.

SITE ADDRESS:
 32700 SE LEEWOOD LANE
 BORING, OR 97009

Renewed Water Right Examination
 #289 WTRD
Jack H. Buswell
 Jack H. Buswell
 RENEWAL DATE 12/31/05

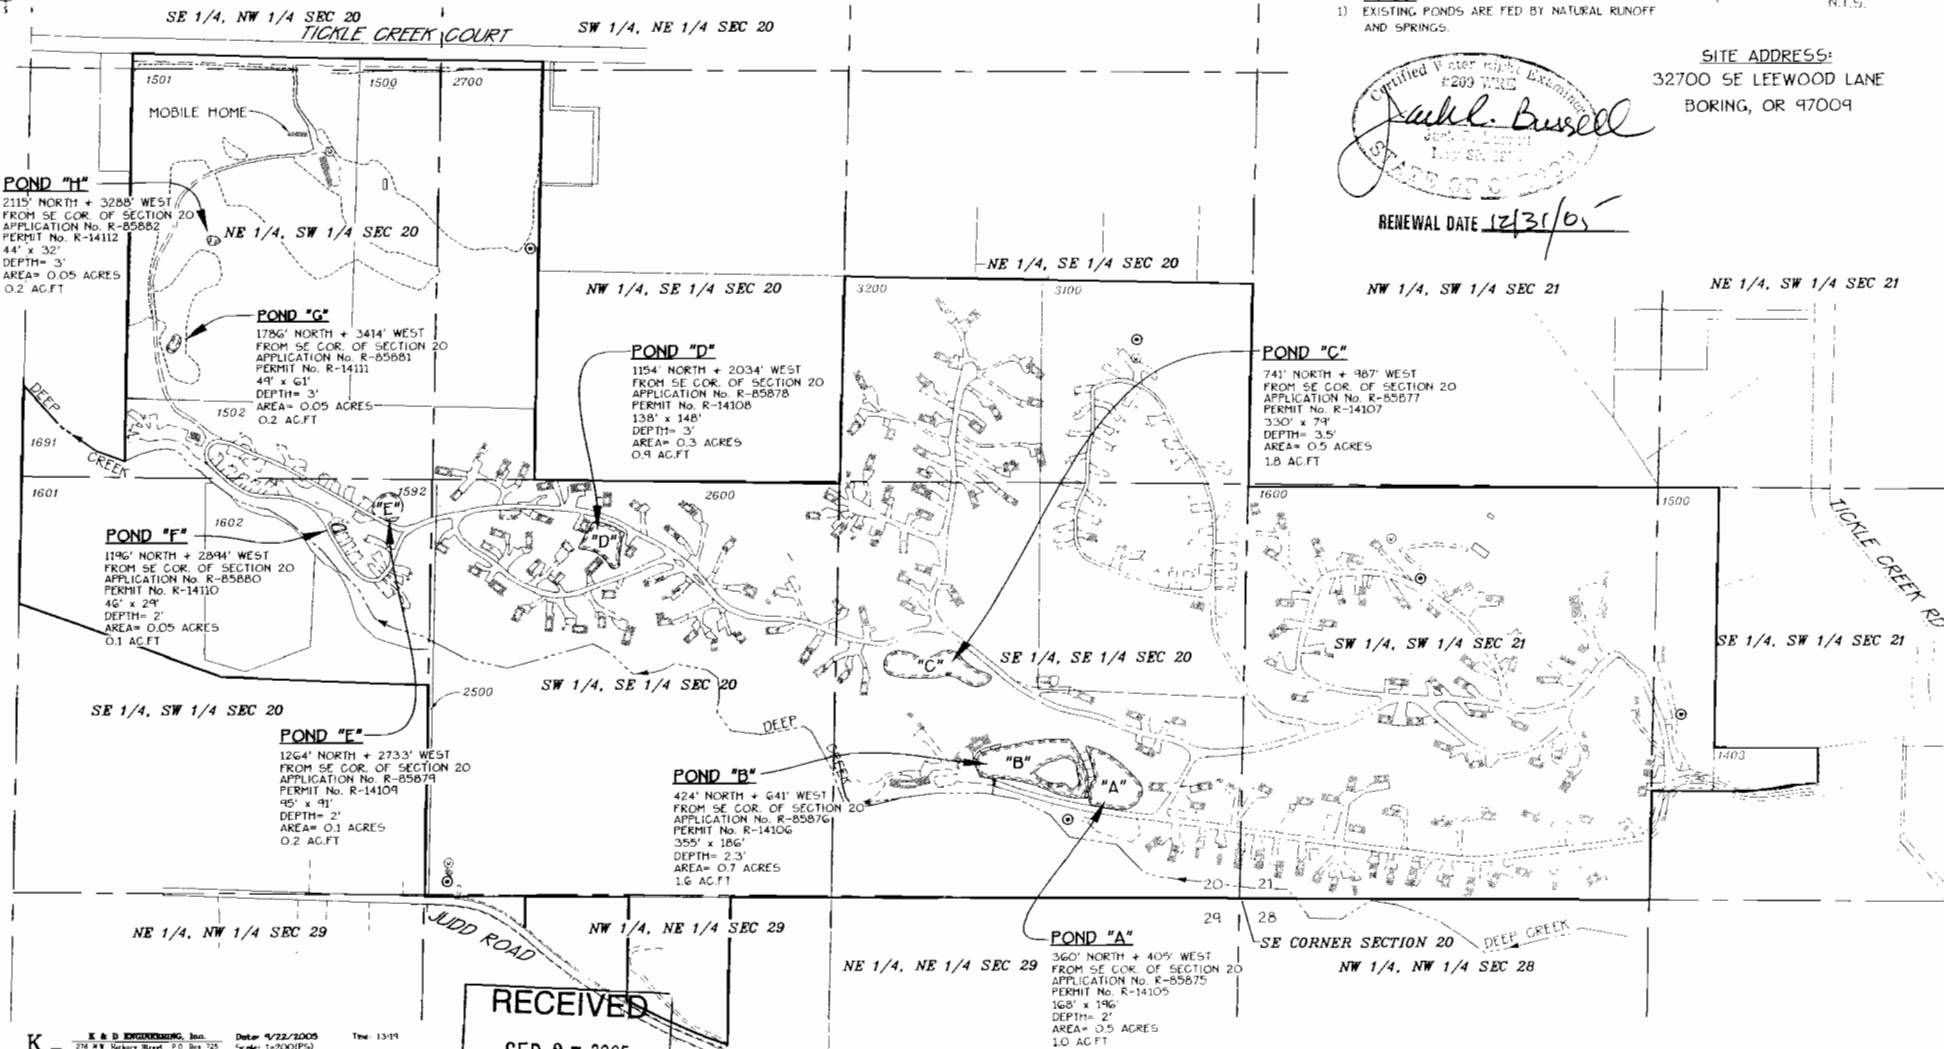

K D K & D ENGINEERING, Inc. Date: 9/22/2005 Time: 13:19
 210 W. Sidney Street, P.O. Box 125, Salem, Oregon 97301
 (503) 585-5883

RECEIVED
 SEP 27 2005
 WATER RESOURCES DEPT
 SALEM, OREGON