



(ALTERNATE RESERVOIR PERMIT PROCESS)
 IN NAME OF
BIG VALLEY WOODS WATER CORPORATION
 LOCATED IN SECTIONS 20 + 21, T. 2 S.,
 R. 4 E., W.M., CLACKAMAS COUNTY, OREGON
 SEPTEMBER 22, 2005

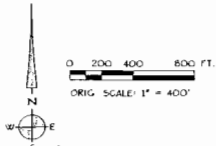

NOTES:
 1) EXISTING PONDS ARE FED BY NATURAL RUNOFF
 AND SPRINGS.

SITE ADDRESS:
 32700 SE LEEWOOD LANE
 BORING, OR 97009

Certified Water Right Examiner
 #209 WRB
Jack L. Buswell
 STATE OF OREGON
 RENEWAL DATE 12/31/05

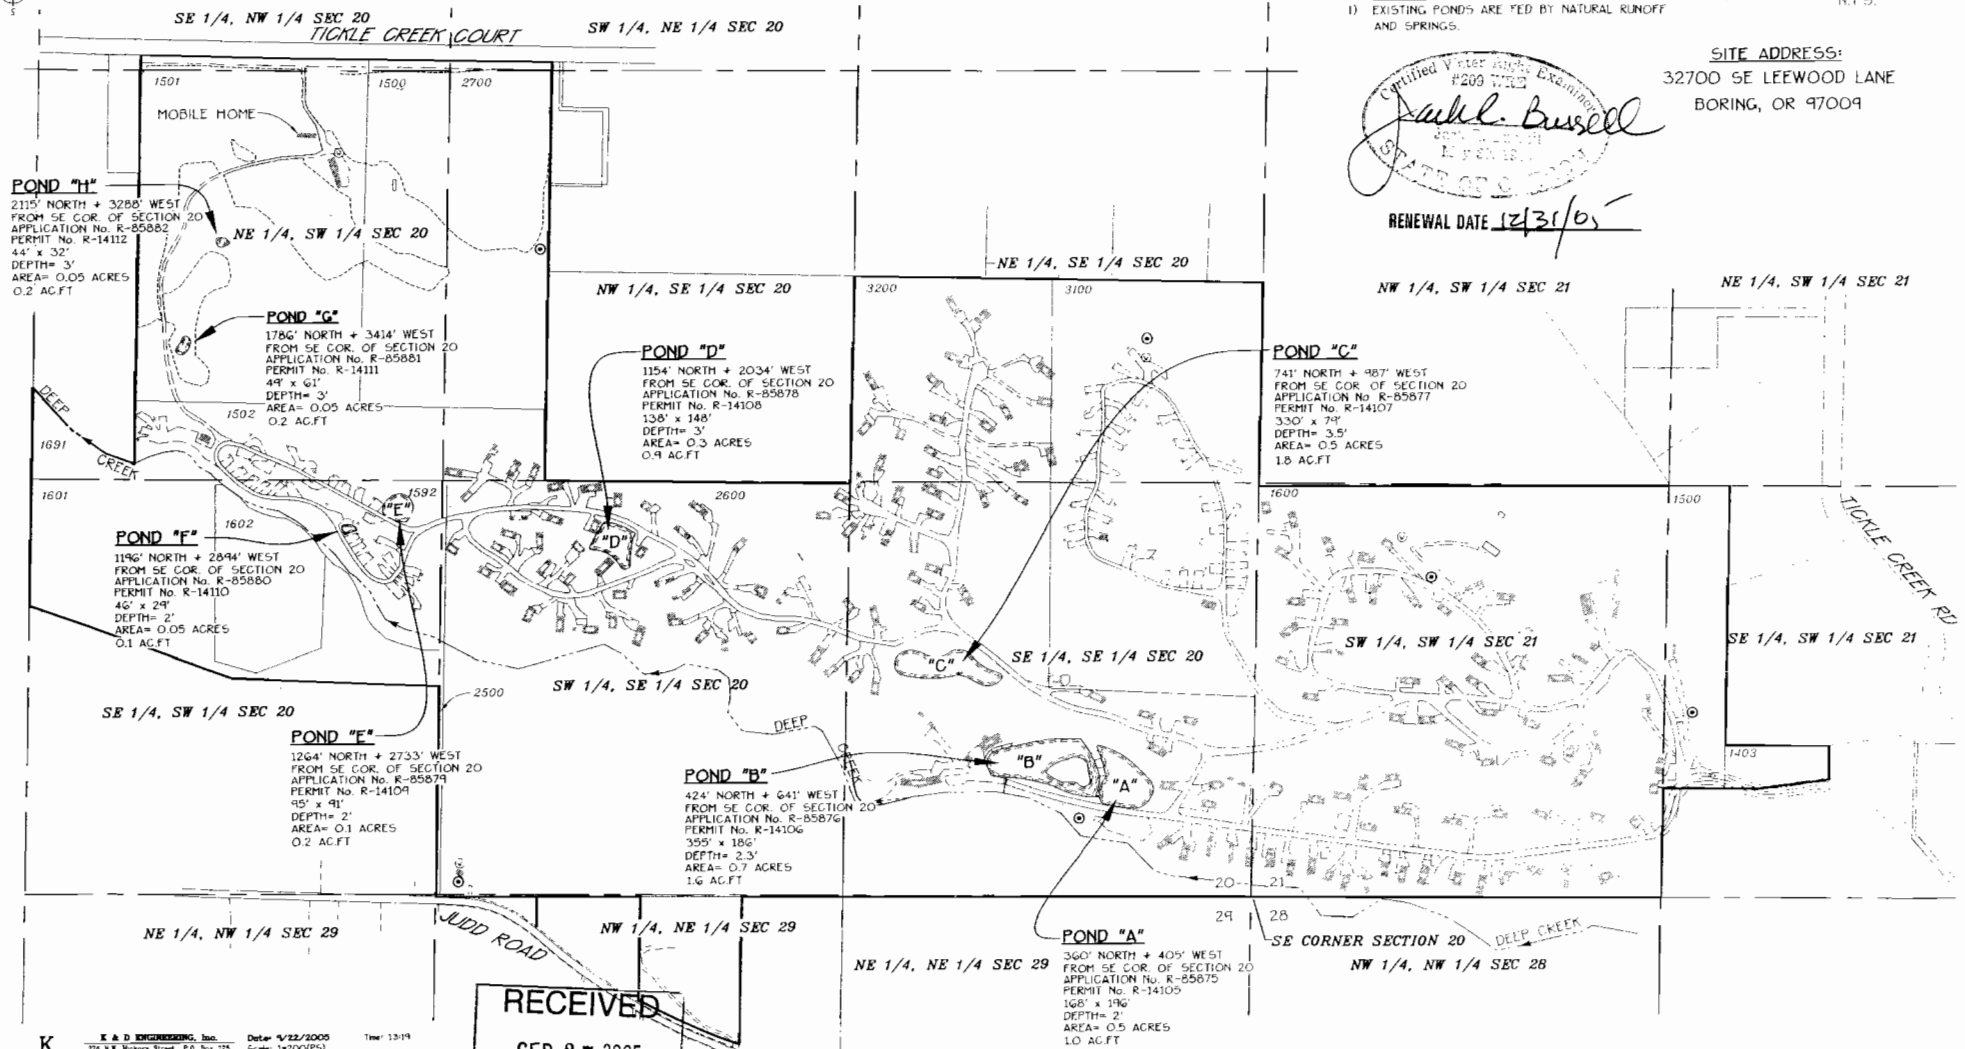

RECEIVED
 SEP 27 2005
 WATER RESOURCES DEPT
 SALEM, OREGON

K D **K & D ENGINEERING, Inc.** Date: 9/22/2005 Time: 13:19
 212 N.W. Valley Street P.O. Box 125 Scale: 1"=200'(0.5)
 Clatsop, Oregon 97141 File: dwp\2002\02-118\118d-wr.dwg (Drian E.)
 (503) 862-1222