
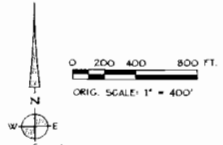



(ALTERNATE RESERVOIR PERMIT PROCESS)
 IN NAME OF
BIG VALLEY WOODS WATER CORPORATION
 LOCATED IN SECTIONS 20 + 21, T. 2 S.,
 R. 4 E., W.M., CLACKAMAS COUNTY, OREGON
 SEPTEMBER 22, 2005

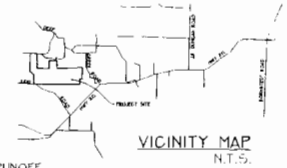

NOTES:
 1) EXISTING PONDS ARE FED BY NATURAL RUNOFF AND SPRINGS.

SITE ADDRESS:
 32700 SE LEEWOOD LANE
 BORING, OR 97009

RENEWAL DATE 12/31/05

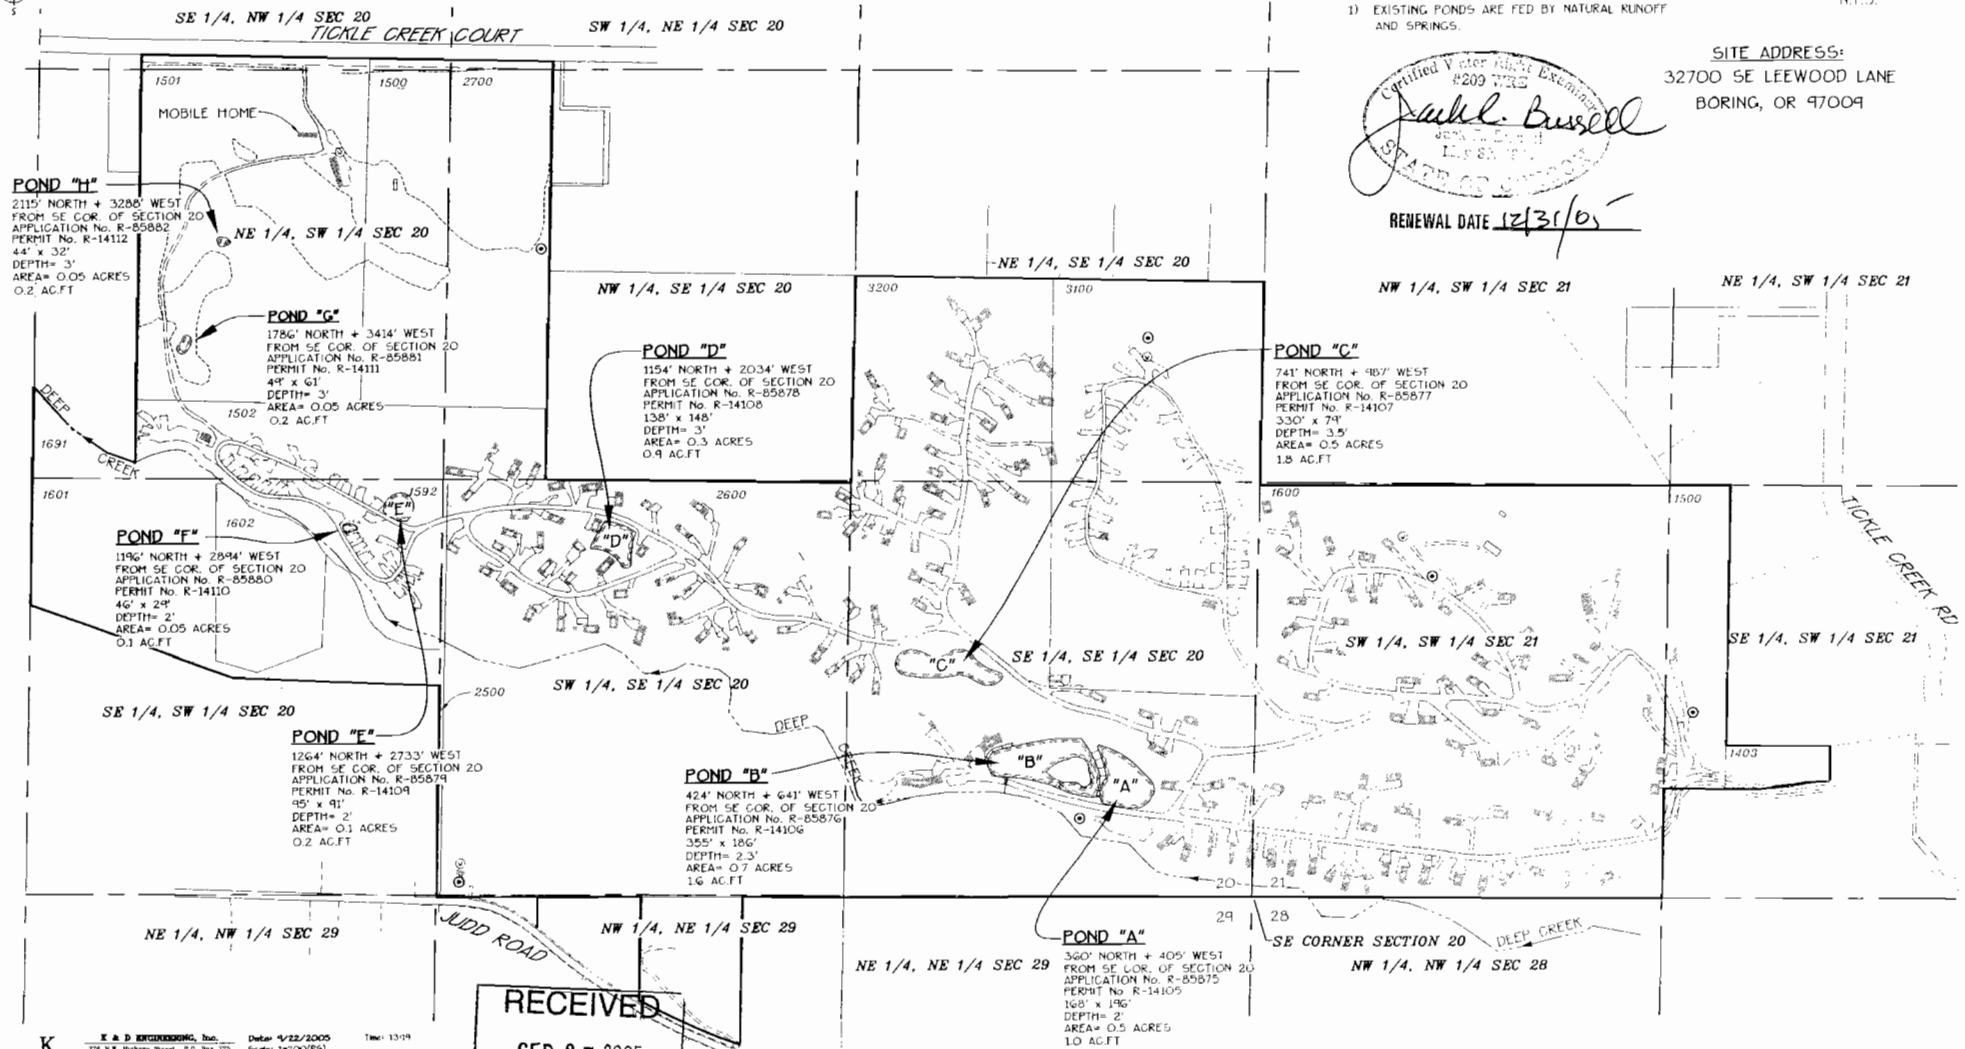

RECEIVED
SEP 27 2005
 WATER RESOURCES DEPT
 SALEM, OREGON

K D **E & D ENGINEERING, Inc.** Date: 9/22/2005 Time: 13:09
 210 N. Highway Street, P.O. Box 125, Salem, Oregon 97301
 (503) 828-8843 Fax: (503) 828-8843