


T. 5 S., R. 10 W., W.M.

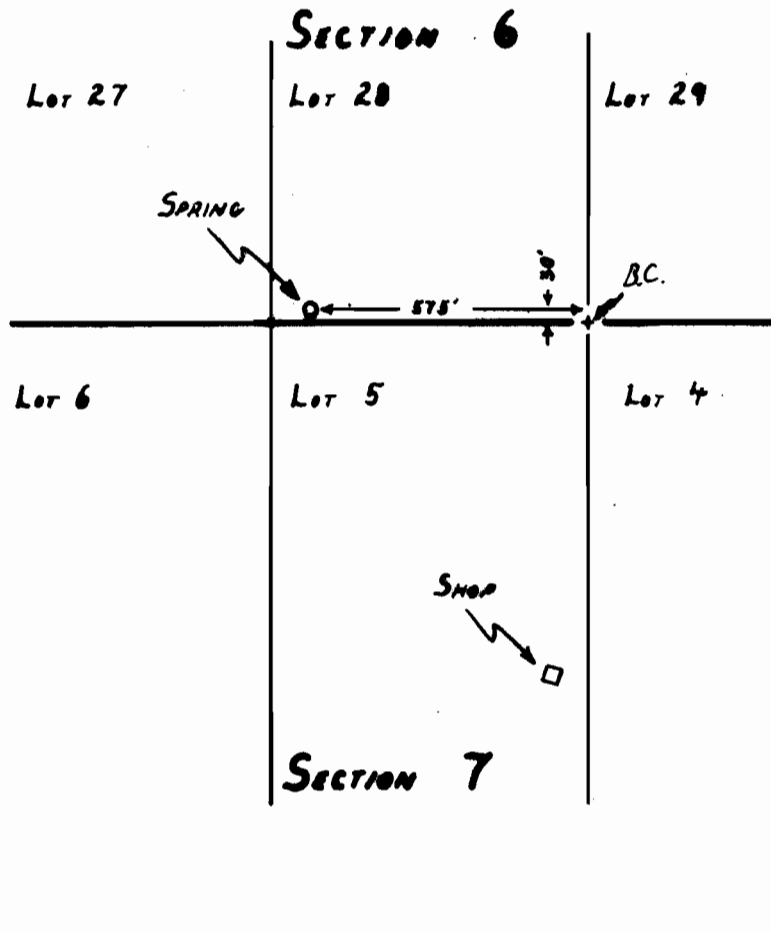

FINAL PROOF SURVEY

UNDER

Application No. 63750 Permit No. 46906
IN NAME OF

CHARLES & MARY ANDERSON

Surveyed SEPTEMBER 21, 1992, by R.W. Klassen