


# T. 1 S., R. 10 W., W.M.

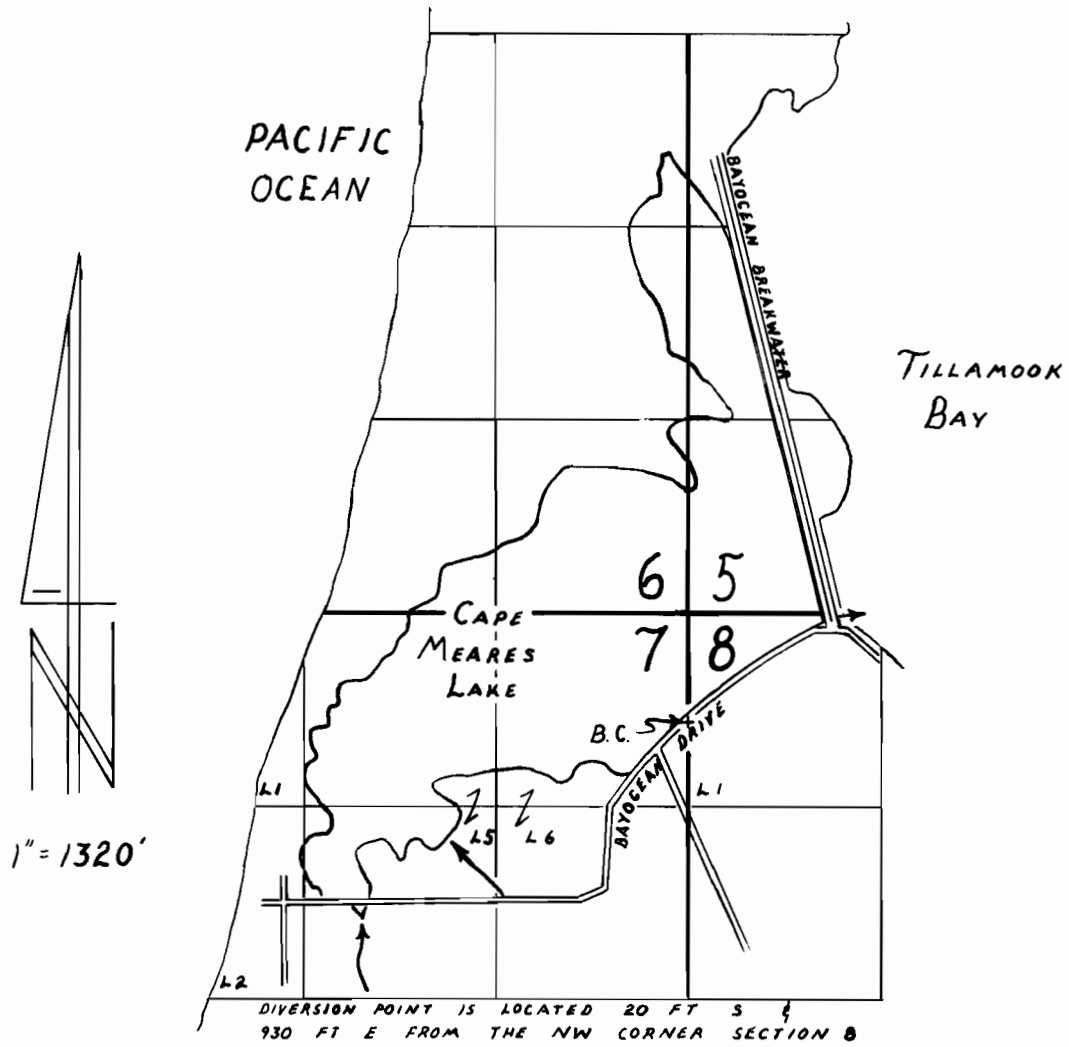

## FINAL PROOF SURVEY

UNDER

Application No. R-68599, 68600 Permit No. R-10602, 49592  
IN NAME OF

Tillamook County

Surveyed July 21, 1993, by R.W. Klassen