



CLAIM OF BENEFICIAL USE FINAL PROOF MAP
 Located in NW¼ SE¼ of Section 21, and the NE¼ NE¼ of
 Section 28, Township 29 South, Range 11 West, W.M.
 Coos County, Oregon
 Application 68048 Permit 48468

Prepared For: Kris & Melissa Horner
 Prepared By: Dennis Goude
 Date Prepared: December 19, 2005



LEGEND

P.O.B.
 P.O.D.
 PIPE

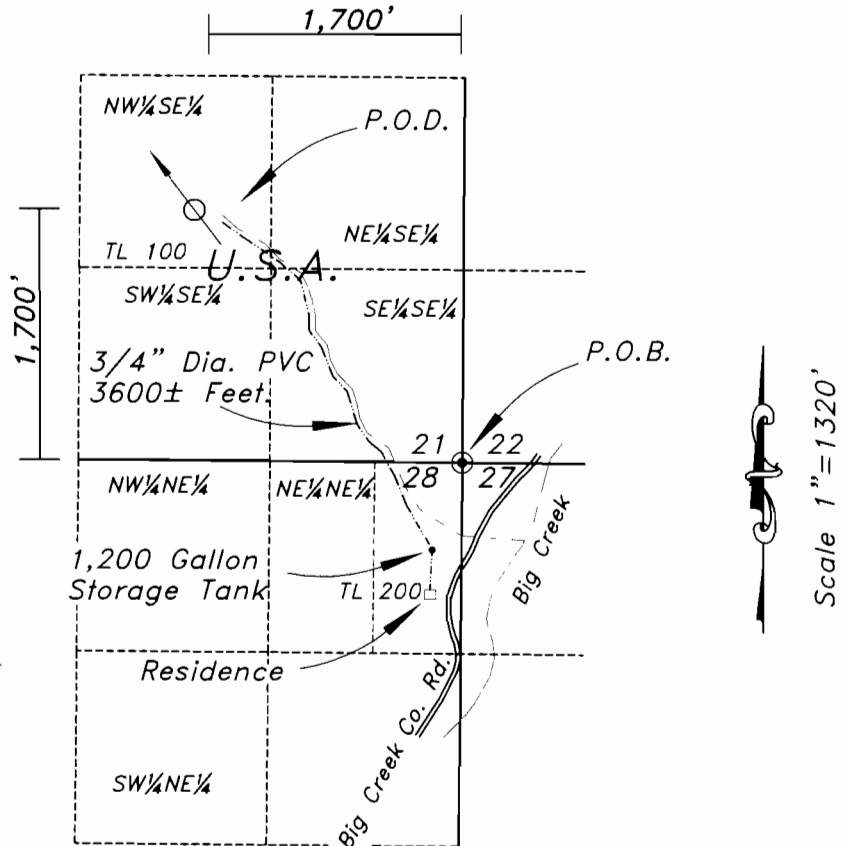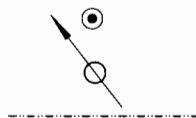

NOTE:

THE POINT OF DIVERSION IS A WOOD AND CONCRETE SPRING BOX WHICH IS LOCATED 1700 FEET NORTH AND 1700 FEET WEST FROM THE SOUTHEAST CORNER OF SECTION 21. DISTANCES WERE ESTABLISHED AT THE TIME OF APPLICATION APRIL 3, 1984. DISTANCES WERE VERIFIED BY SITE VISIT AND BLM AERIAL PHOTO 33-29.1-33.

RECEIVED

FEB 07 2006

WATER RESOURCES DEPT
 SALEM, OREGON

EXAMINERS DISCLAIMER STATEMENT

The preparation of this map was for the purpose of identifying the location of the Water Right only and has no intent to provide dimensions or location of property ownership lines.

**Stuntzner Engineering
 & Forestry, L.L.C.**

ENGINEERING • LAND SURVEYING • FORESTRY
 PLANNING • WATER RIGHTS

705 South 4th St.
 Post Office Box 118
 Coos Bay, Oregon 97420

Phone: (541) 267-2872
 Fax: (541) 267-0588