


T. 8S. R. 39E. W. M.

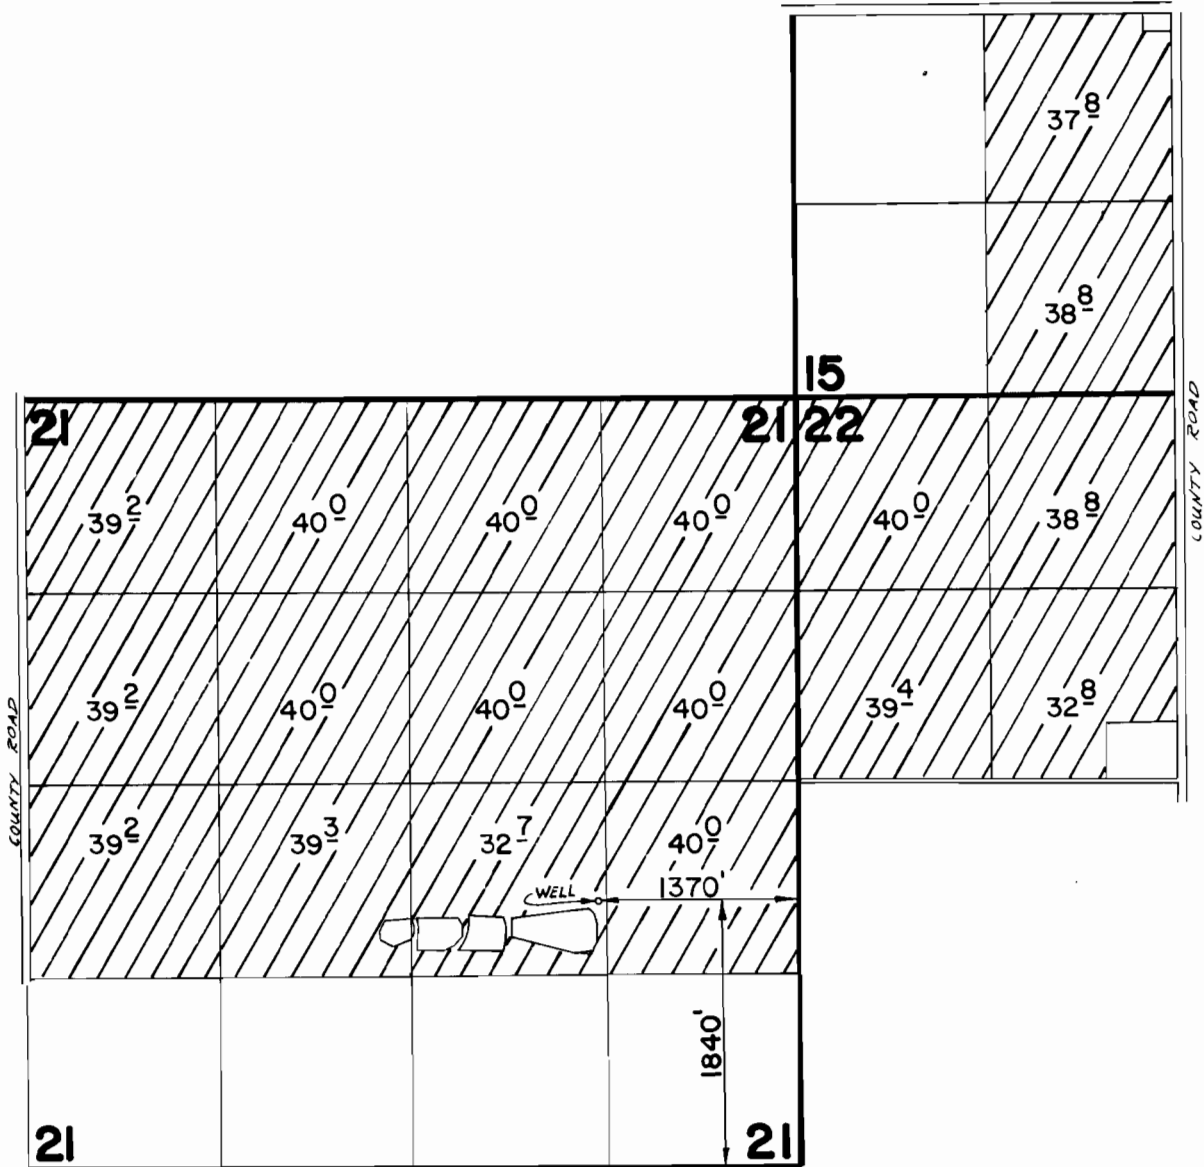

FINAL PROOF SURVEY
UNDER

Application No. G-8202 Permit No. G-7630
IN NAME OF

NORBERT & DESMOND SIEG

Surveyed 7-28 1977, by V. CHURCH