



(ALTERNATE RESERVOIR PERMIT PROCESS)  
 IN NAME OF  
**BIG VALLEY WOODS WATER CORPORATION**  
 LOCATED IN SECTIONS 20 + 21, T. 2 S.,  
 R. 4 E., W.M., CLACKAMAS COUNTY, OREGON  
 SEPTEMBER 22, 2005

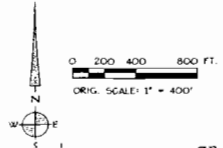

**NOTES:**  
 1) EXISTING PONDS ARE FED BY NATURAL RUNOFF AND SPRINGS.

**SITE ADDRESS:**  
 32700 SE LEEWOOD LANE  
 BORING, OR 97009

**RENEWAL DATE 12/31/05**

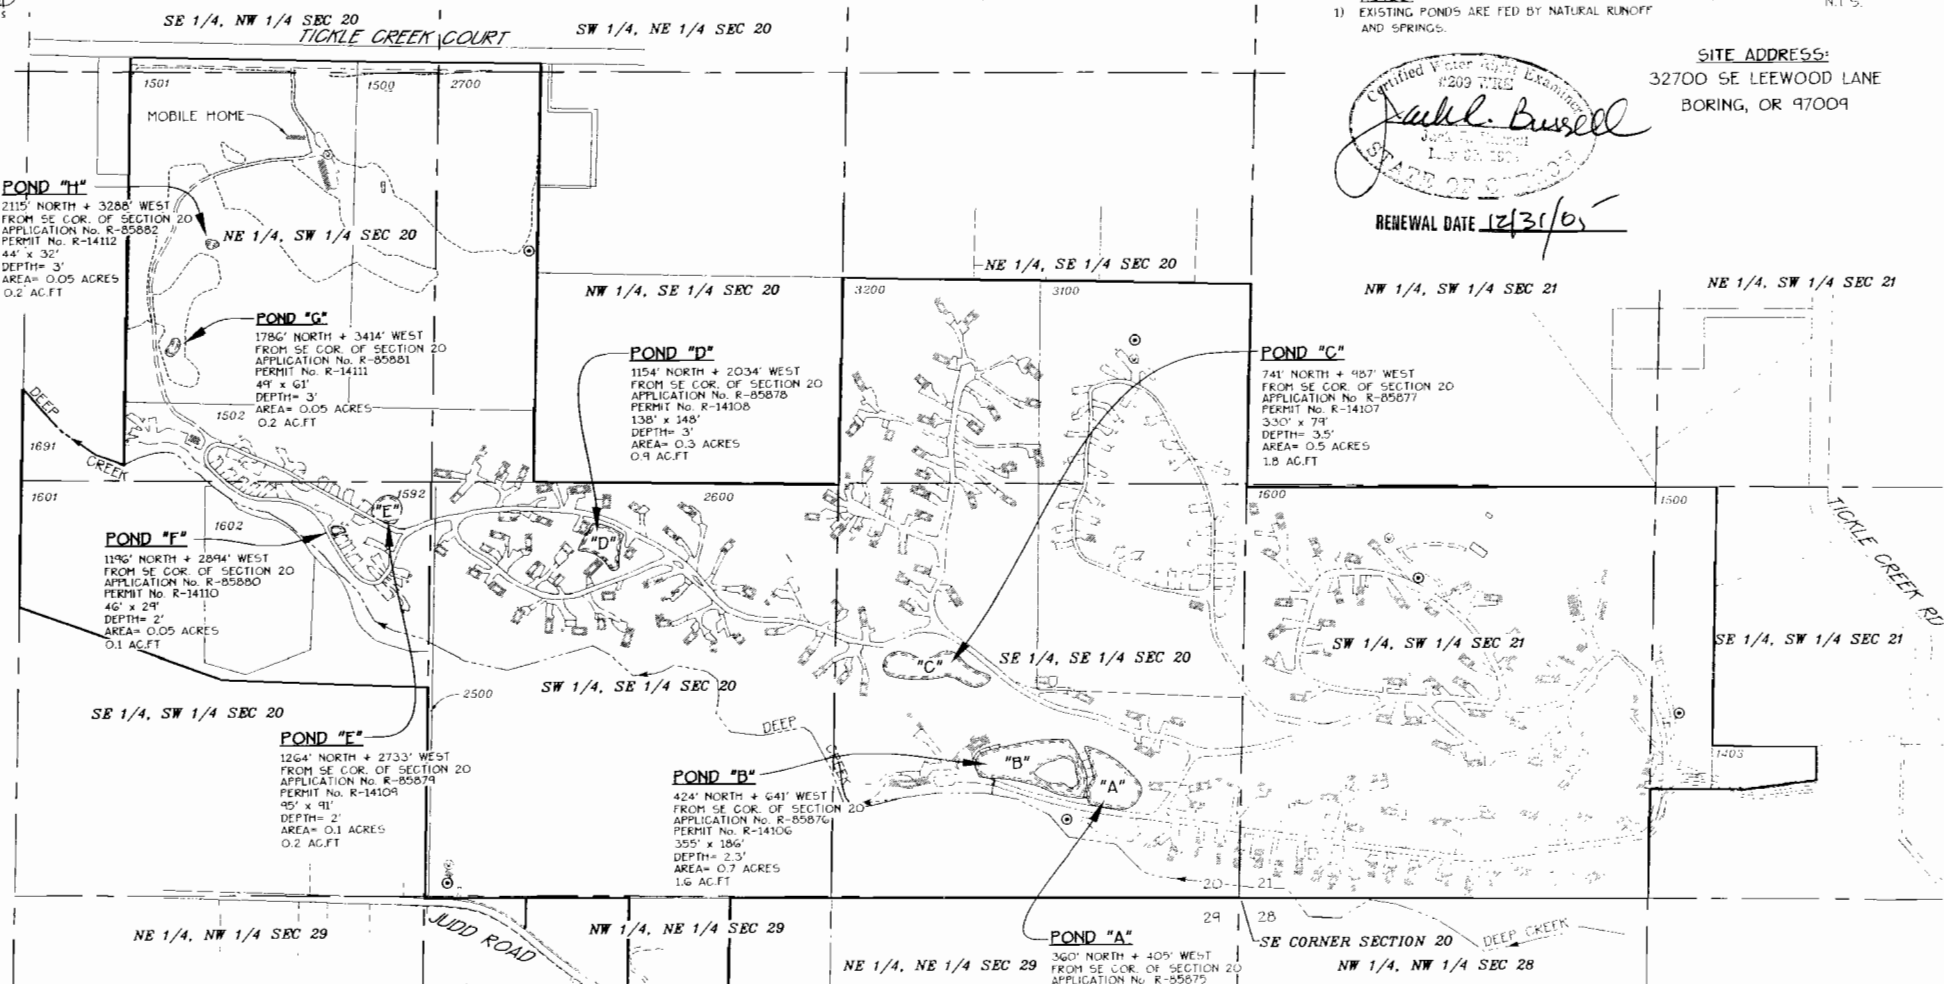

**RECEIVED**  
 SEP 27 2005  
 WATER RESOURCES DEPT  
 SALEM, OREGON

**K D** K & D ENGINEERING, Inc. Date: 9/22/2005 Time: 1:11P  
 216 N.W. Highway Street, P.O. Box 125 Scale: 1:2000(PS)  
 Albany, Oregon 97141 Phone: (503) 325-1251 Fax: (503) 325-1251  
 File: deg\2005\02-118\118d-wr4.dwg (Draw 2)