
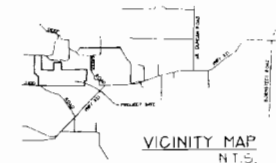


(ALTERNATE RESERVOIR PERMIT PROCESS)  
 IN NAME OF  
**BIG VALLEY WOODS WATER CORPORATION**  
 LOCATED IN SECTIONS 20 + 21, T. 2 S.,  
 R. 4 E., W.M., CLACKAMAS COUNTY, OREGON  
 SEPTEMBER 22, 2005

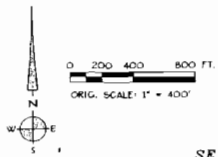


**NOTES:**  
 1) EXISTING PONDS ARE FED BY NATURAL RUNOFF AND SPRINGS.

**SITE ADDRESS:**  
 32700 SE LEEWOOD LANE  
 BORING, OR 97009

Certified Water Right Examination  
 #209 WRB  
*Paul Busell*  
 JAMES H. BUSELL  
 STATE OF OREGON

RENEWAL DATE 12/31/05

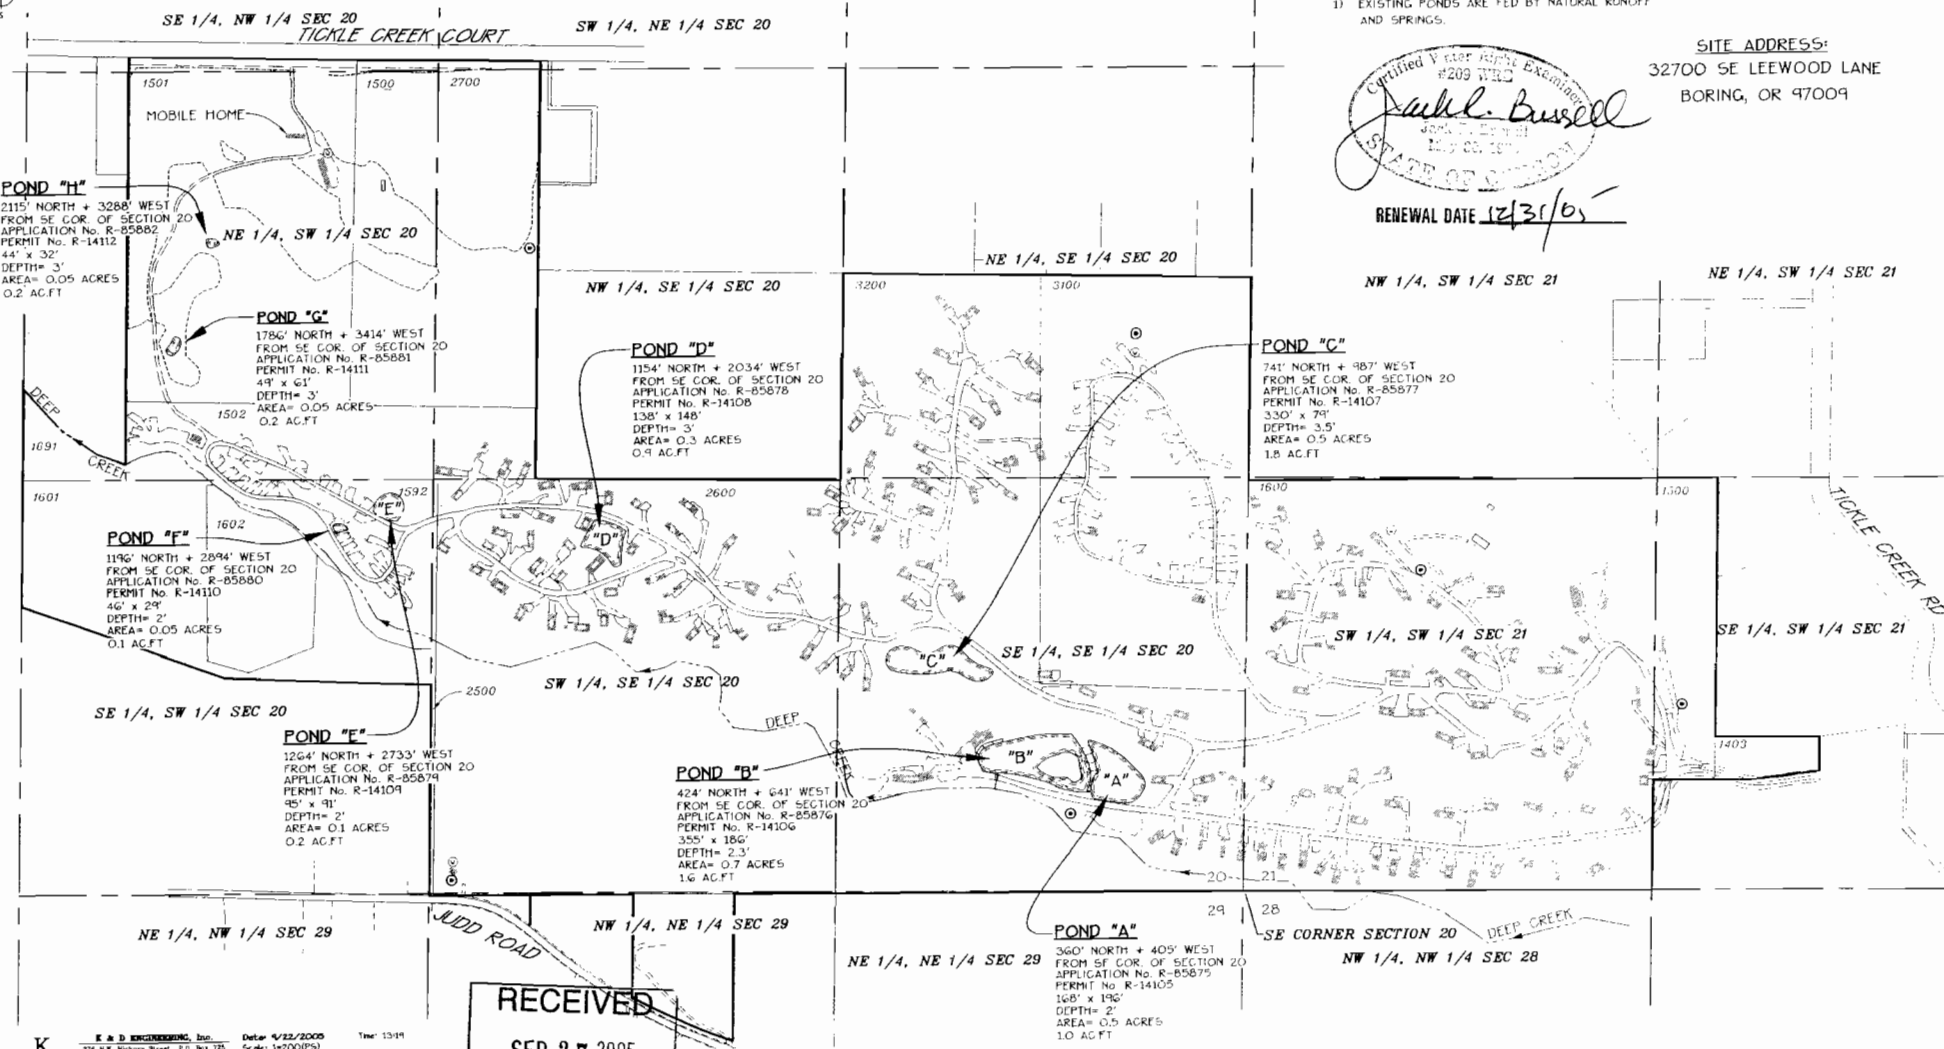

 Albany, Oregon 97141 Phone: (503) 881-8551 Fax: (503) 881-8551  
 File: dwg\2002\02-118\1180-vr4.dwg (Draw 1)

**RECEIVED**  
 SEP 27 2005  
 WATER RESOURCES DEPT  
 SALEM, OREGON