RECEIVED

SEP 27 2005

WATER RESOURCES DEPT
SALEM, OREGON

Certified Water Right Examiner
#209 WRE
Jack R. Burrell
Jack R. Burrell
May 30, 1989
STATE OF OREGON

RENEWAL DATE 12/31/05

(ALTERNATE RESERVOIR PERMIT PROCESS)
IN NAME OF
BIG VALLEY WOODS WATER CORPORATION
LOCATED IN SECTIONS 20 + 21, T. 2 S.,
R. 4 E., W.M., CLACKAMAS COUNTY, OREGON
SEPTEMBER 22, 2005

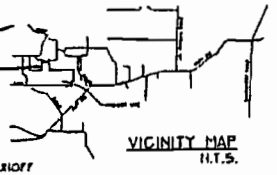

NOTES:
1) EXISTING PONDS ARE FED BY NATURAL RUNOFF AND SPRINGS.

SITE ADDRESS:
32700 SE LEEWOOD LANE
BORING, OR 97009

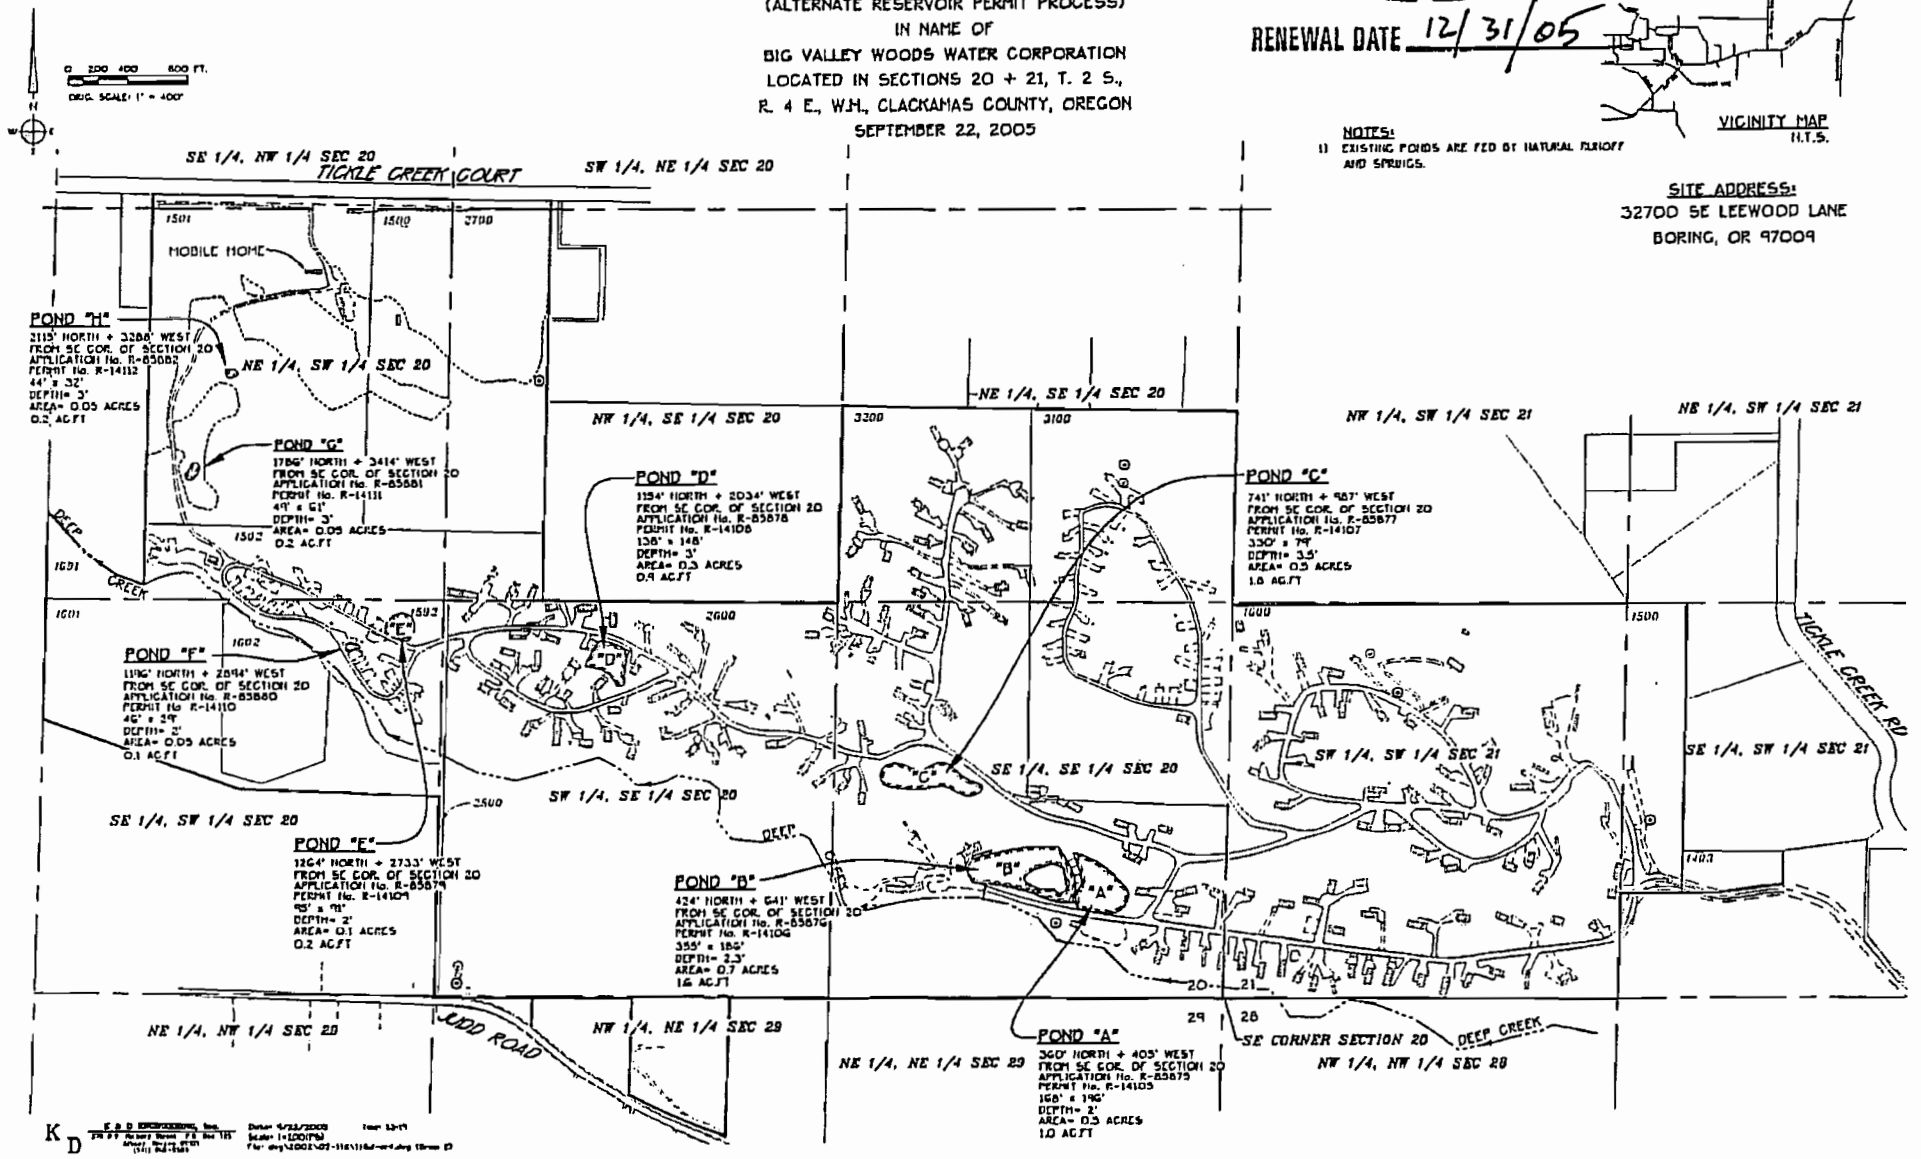

K D